

WARREN  
 Q 2002  
 03-21-79

MISSISSIPPI  
 BOARD OF WATER COMMISSIONERS  
 416 North State Street  
 Jackson, Mississippi 39201

WATER WELL DRILLERS LOG

March 21 19 79 Grenn Water Well Warren  
 date well completed firm name county well located

LANDOWNER: Robert Rollison  
 Route 2  
 Vicksburg, Ms.  
 (mailing address)

description of formations encountered	from	to
Loess	1	25
white clay	25	45
sand & gravel	45	55
white clay	55	65
blue clay	65	150
sand	150	167

WELL LOCATION:  
 sec. 7 T. 13 N. R. 2 E  
 S W  
 19 miles S of Vicksburg  
 (distance) (direction) (nearest town)

WELL PURPOSE: home  
 (home, irrigation, municipal, industrial)

WELL COMPLETION DATA:

(1) diameter (inches) 4

(2) total depth (feet) 167

(3) static water level (feet) 65 below top of ground.

(4) casing PVC 155' (material), (depth)  
 4" (size) if telescope see back.

(5) screen 12' 155' (length), (depth to top)  
 .010 PVC (size), (material)

(6) pump 3/4 sub 10 (HP), (yield gpm)  
 electricity (type power)

(7) electric log no (yes or no)  
 (organization running log)

(8) how well bottom plugged backwash valve

DRILLERS REMARKS:


Miss. Board of Water Comm.

MAY - 9 1979

RECEIVED

If well telescopes please sketch and show depths.

GROUND LEVEL

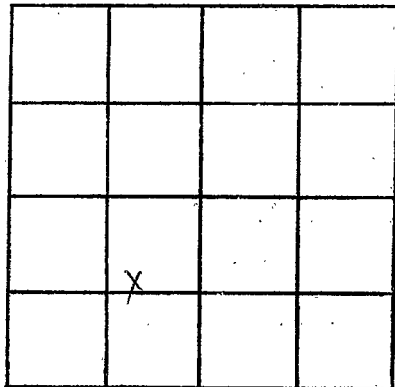

SECTION 7

Please indicate well location X.

ADDITIONAL INFORMATION

Lined area for additional information.

If more than one screen, show locations of each on sketch.