

WARREN

R

4-15-66

WATER WELL DRILLERS LOG

Date: 4-15, 1966, Driller: Alvin Gettysburg County Warren
(Name)

(1) Owner of Land:	Description & Color of Materials Sand, Clay, Red Clay, Shell, etc.	Thick- ness Feet	Depth Feet
<u>D. W. Dumasley</u> (Name) <u>Wicksburg, Miss.</u> (Address)	<u>0 - 60 clay</u> <u>60 - 153 red shale</u> <u>153 - 164 blue sand</u>		
(2) Location: <u>1/4</u> , <u>1/4</u> , Sec. <u> </u> T. <u> </u> R. <u> </u> <u>12</u> miles <u>south</u> , of <u>Wicksburg</u> (distance) (direction) (Nearest Town)			
(3) Topography: <u>Hilly</u> (Hilly) (Flat) (Level)			
(4) Purpose of Well: <u>Home</u> (Domestic Irrigation Municipal, Industrial, Other)			


Information upon completion of well:

- (1) Diameter 3 inches.
- (2) Total Depth 164 feet.
- (3) Water Level 110 feet below top of ground.
- (4) Cased to 154, Size 2"
- (5) Screen: Size 2", Length 10'
- (6) Were any formations sealed against pollution?
 yes, NO no.

If YES, depth of formation _____

Why _____

Drillers Remarks: _____

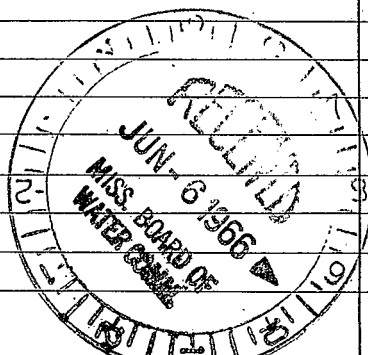

(Use Back Side)

Well No.

100