

WARREN
R 14
12-18-69

MISSISSIPPI
BOARD OF WATER COMMISSIONERS
416 North State Street
Jackson, Mississippi 39201
WATER-WELL DRILLERS LOG

CODED

12/18/1969 19 Robert E. Ratliff Warren
date well completed firm name county well located

LANDOWNER: Fisher Ferry
Water Assn.
Warren County, Miss.
(mailing address)

description of formations encountered	from	to
Clay and Sand	0	20
Clay	20	80
Sand and Clay	80	160
Clay	160	300
Fine Sand	300	395

WELL LOCATION:
sec. 1 T 14 N R 3 E
5 miles SE of Vicksburg
(distance) (direction) (nearest town)

WELL PURPOSE: Community
(home, irrigation, municipal, industrial)

- WELL COMPLETION DATA:
- (1) diameter (inches) 8"
 - (2) total depth (feet) 363
 - (3) static water level (feet) 70' below top of ground.
 - (4) casing Blk Stl 303
(material) (depth)
8" if telescope see back.
(size)
 - (5) screen 60' 303
(length) (depth to top)
4" SS
(size) (material)
 - (6) pump 20 250
(HP) (yield gpm)
Elec.
(type power)
 - (7) electric log Yes
(yes or no)
USGS
(organization running log)
 - (8) how well bottom plugged
Back Press Valve

WELL


AUG 6 1970

DRILLERS REMARKS:

(X)

If well telescopes please sketch and show depths.

GROUND LEVEL

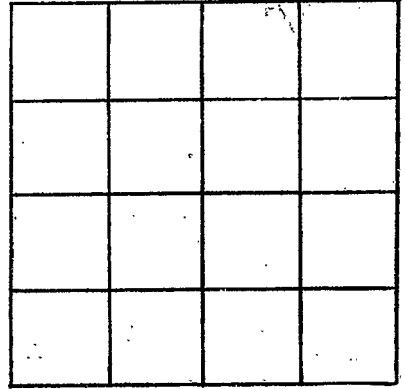

SECTION _____

Please indicate well location X.

ADDITIONAL INFORMATION

Lined area for providing additional information, consisting of approximately 18 horizontal lines.

If more than one screen, show locations of each on sketch.