

Warren  
R 15  
6-26-68

MISSISSIPPI  
BOARD OF WATER COMMISSIONERS  
416 North State Street  
Jackson, Mississippi 39201

**CODED**  
**CODED**  
**CODED**

WATER WELL DRILLERS LOG

6-26-1968 date well completed  
BIG BLACK DRILLING Co. firm name  
WARREN county well located

LANDOWNER: BILL GULLETT

description of formations encountered

from

to

RT. 2

VIKESBURG MISS  
(mailing address)

CLAY

0' 15'

BLUE CLAY

15' 65'

WELL LOCATION:

sec. 47 T. 14 N. R. 3 E.  
4 miles SE of Yokona  
(distance) (direction) (nearest town)

SAND FROM FINE  
TO PEA GRAVEL

65' 80'

WELL PURPOSE: FARM  
(home, irrigation, municipal, industrial)

WELL COMPLETION DATA:

- (1) diameter (inches) 4"
- (2) total depth (feet) 80'
- (3) static water level (feet) 12' below top of ground.
- (4) casing GALV., 70' (material) (depth)  
4" (size) if telescope see back.
- (5) screen 10, 70' (length) (depth to top)  
4" STAINLESS STEEL (size) (material)
- (6) pump 1 1/2 HP, 30 GAL (yield gpm)  
ELECTRIC (type power)
- (7) electric log NO (yes or no)
- (organization running log)
- (8) how well bottom plugged BACK WASH VALVE

**CODED**

**CODED**

JAN - 6

DRILLERS REMARKS:


MISS. BD. OF  
WATER COMMISSIONERS

If well telescopes please sketch and show depths.

GROUND LEVEL

70' 4" GALV.  
PIPE

10' of 010000  
Slot Johnson  
SCREEN with  
2" BACK WASH  
VALVE

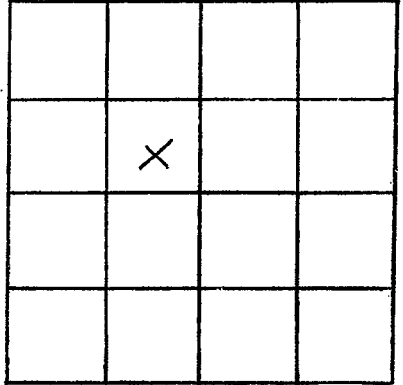

SECTION 47

Please indicate well location X.

ADDITIONAL INFORMATION

Multiple horizontal lines for additional information.

If more than one screen,  
show locations of each on sketch.