

Warren
R16
3-29-68

MISSISSIPPI
BOARD OF WATER COMMISSIONERS
416 North State Street
Jackson, Mississippi 39201

CODED

CODED

WATER WELL DRILLERS LOG

3-29 1968 BIG BLACK DRILLING Co. WARREN
date well completed firm name county well located

LANDOWNER: ELMER RILEY
OLD HWY 61 SOUTH
PT 2, BOX 188C
WICKS BURG, MISS
(mailing address)

description of formations encountered	from	to
RED CLAY	0'	40'
BLUE CLAY	40'	68'
ROCK	68'	112'
BLUE SHALE	112'	233'
SAND	233'	238'

WELL LOCATION:
sec 26 T 14 N R 3 E
2 miles E of Tokena
(distance) (direction) (nearest town)

WELL PURPOSE: HOME
(home, irrigation, municipal, industrial)

- WELL COMPLETION DATA:
- (1) diameter (inches) 2"
 - (2) total depth (feet) 238'
 - (3) static water level (feet) 210' below top of ground.
 - (4) casing GALV. 233'
(material) (depth)
2" if telescope see back.
(size)
 - (5) screen 5' 233'
(length) (depth to top)
1 1/4" STAINLESS STEEL
(size) (material)
 - (6) pump 2 5 GAL
(HP) (yield gpm)
ELECTRIC
(type power)
 - (7) electric log NO
(yes or no)
 - (organization running log)
 - (8) how well bottom plugged 1 1/4"
GALV. PIPE PLUG

CODED

JAN - 6 1968

MISS. BD. OF
WATER COMMISSIONERS


DRILLERS REMARKS:

If well telescopes please sketch and show depths.

GROUND LEVEL

233' of GALV.
CASING

5' of 1 1/4"
STAINLESS STEEL
SCREEN WITH
2' of 1 1/4"
GALV. PIPE
WITH 2" RUBBER
SEAL WELL
PACKER.

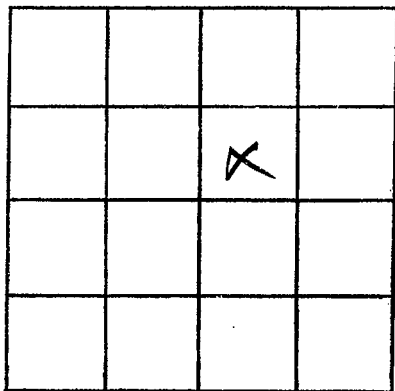

SECTION 26

Please indicate well location X.

ADDITIONAL INFORMATION

If more than one screen,
show locations of each on sketch.