

CODED

CODED

Warren
R 17
11-22-67

MISSISSIPPI
BOARD OF WATER COMMISSIONERS
416 North State Street
Jackson, Mississippi 39201

WATER WELL DRILLERS LOG

Nov. 22, 1967, Big Black Drilling Co. WARREN
date well completed firm name county well located

LANDOWNER: Peck Gullet

R-1 - Box 206 A
Vicksburg Miss.
(mailing address)

description of formations encountered	from	to
Red Clay	0	32
Red clay Gravel	32	44
White Clay	44	70
Blue Clay	70	92
Lime Rock	92	93
Blue shale	93	113
Sand	113	116
Good Sand	116	122
Blue shale	122	

WELL LOCATION:

SE NW Sec 14 T 14 N R 3 E
5 miles NE of Yokena
(distance) (direction) (nearest town)

WELL PURPOSE: Home & Farm
(home, irrigation, municipal, industrial)

WELL COMPLETION DATA:

- (1) diameter (inches) 2"
- (2) total depth (feet) 122'
- (3) static water level (feet) 90' below top of ground.
- (4) casing Galv. 116' (material) (depth)
1 1/4" if telescope see back. (size)
- (5) screen 5' 116' (length) (depth to top)
- 1 1/4" SS Ribed Pipe (size) (material)
- (6) pump 1 7 Gal. (HP) (yield gpm)
Elec. (type power)
- (7) electric log NO. (yes or no)

(organization running log)

(8) how well bottom plugged 1 1/4 Galv. pipe plug

DRILLERS REMARKS:

JAN - 6 1968

MISS. BD. OF
WATER COMM.



If well telescopes please sketch and show depths.

GROUND LEVEL

116'
2" GALV.

5' 1/4
SCREEN
10" 1/4

GALV. Tail
Pipe
with 1/4
GALV. Pipe
Plus

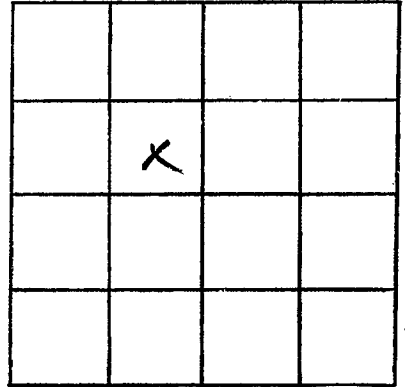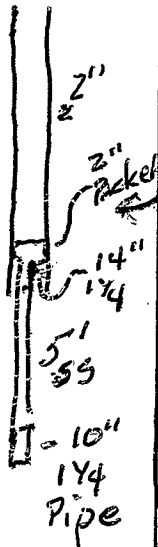

SECTION 5

Please indicate well location X.

ADDITIONAL INFORMATION

Well Drilled To
116' CASING set 2"
AND Drove IN TO
SAND THEN DRILLED
OUT THROUGH INSIDE
TO DEPTH 122'
SCREEN THEN INST.
AND TIED IN WITH
2" RUBBER SEAL
PACKER

If more than one screen, show locations of each on sketch.