

Wanam
R 20
3-24-62

WATER WELL DRILLERS LOG

CODED

OK 7/29/69

Date: 3-24, 19 62 Driller: J. L. Smith County: Warren

(1) Owner of Land: J. P. Smith
(Name)
Smith (Address)

(2) Location: 1/4, 1/4, Sec. 32, T. 43, R. 3
6 miles SE of Abbeville
(distance) (direction) (Nearest Town)

(3) Topography: Level
(Hilly) (Flat) (Level)

(4) Purpose of Well: Domestic
(Domestic, Irrigation, Municipal, Industrial, Other)

Description & Color of Materials Sand, Clay, Red Clay, Shell, etc.	Thick- ness Feet	Depth Feet
0-120' red clay		
120-130' sandstone		
hard gravel		

Information upon completion of well:

(1) Diameter: 7 inches.

(2) Total Depth: 129 feet.

(3) Water Level: 112 feet below top of ground.

(4) Cased to: 129, Size: 2

(5) Screen: Size: 2, Length: 5

(6) Were any formations sealed against pollution?


yes, no.

If YES depth of formation

Why

Drillers Remarks:

very good well

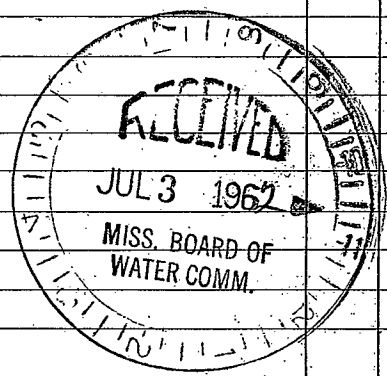

(Use Back Side)

Well No.

