

WARREN
 R ~~21~~ 21
 7-21-70

MISSISSIPPI
 BOARD OF WATER COMMISSIONERS
 416 North State Street
 Jackson, Mississippi 39201

CODED

WATER WELL DRILLERS LOG

7/21 1970 BIG BLACK DRILLING CO. WARREN
 date well completed firm name county well located

LANDOWNER: MR. JACK
K. FULFORD
RT 2, VICKSBURG, MISS
 (mailing address)

description of formations encountered	from	to
TOP SOIL	0	20
WHITE CHALK	20	30
BROWN SHALE	30	56
WHITE CHALK	56	67
SAND	67	68
WHITE CHALK	68	84
LIME ROCK	84	85
BLUE SHALE	85	120
CHALK & SHALE STRATA	120	170
SAND	170	190

WELL LOCATION:
 sec. 11 T. 14 N. R. 3 E
 APRX. 10 miles S-S-E of VICKSBURG, MISS
 (distance) (direction) (nearest town)

WELL PURPOSE: HOME
 (home, irrigation, municipal, industrial)

WELL COMPLETION DATA:

(1) diameter (inches) 2"

(2) total depth (feet) 191 ft.

(3) static water level (feet) 126 below above top of ground.

(4) casing 2" GALV. 185'
 (material) (depth)

 If telescope see back.
 (size)

(5) screen 6' 185'
 (length) (depth to top)

2" STAINLESS STEEL
 (size) (material)

(6) pump RID PUMP APRX. 39 GAL.
 (HP) (yield gpm)

ELECTRIC
 (type power)

(7) electric log NO
 (yes or no)

 (organization running log)

CODED

AUG 6 1970


(8) how well bottom plugged
BACK WASH VALVE
2 PLUGGED

MISS. BD. OF
 WATER COM.

DRILLERS REMARKS:

If well telescopes please sketch and show depths.

GROUND LEVEL

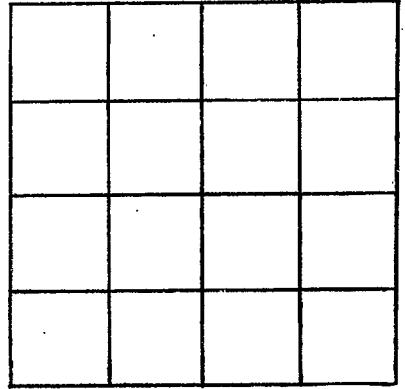

SECTION _____

Please indicate well location X.

ADDITIONAL INFORMATION

If more than one screen, show locations of each on sketch.