

MS GW-2694

MISSISSIPPI

BOARD OF WATER COMMISSIONERS

416 North State Street

Jackson, Mississippi 39201

CODED

Warren
R 26
12-26-79
Edg 161

WATER WELL DRILLERS LOG

TOM GRIFFITH

WARREN

12-26 19 79
date well completed

PLUMBING & WELL SERVICE, INC.

county well located

320 MAYSON AVE.

COLUMBIA, MS 39429

LANDOWNER:

description of formations encountered

from

to

FISHER FERRY WATER

TOPSOIL

0 3

DISTRICT

GRAVEL

3 12

(mailing address)

SAND

12 90

WELL LOCATION:

CHALK

90 150

sec 1 T 14 N R 3 E
S W

SAND

150 200

5 miles S of Vicksburg
(distance) (direction) (nearest town)

CHALK

200 275

SAND

275 280

WELL PURPOSE:

(home, irrigation, municipal, industrial)

CHALK

280 34

SAND

346 460

WELL COMPLETION DATA:

- (1) diameter (inches) 10
- (2) total depth (feet) 460
- (3) static water level (feet) 192 below above top of ground.

CODED

- (4) casing BLACK T.C. 349
(material) (depth)

10 (size) if telescope see back.

- (5) screen 60" 340
38" 250
(length) (depth to top)

6" 5.5
(size) (material)

- (6) pump 30 250
(HP) (yield gpm)

ELECTRIC
(type power)

- (7) electric log YES
(yes or no)

MISS GEO SURVEY
(organization running log)

- (8) how well bottom plugged BSV

DEPT. OF NATURAL RESOURCES
BUREAU OF LAND & WATER RESOURCES

JAN 2 1980


RECEIVED

DRILLERS REMARKS:

(X)

If well telescopes please sketch and show depths.

GROUND LEVEL

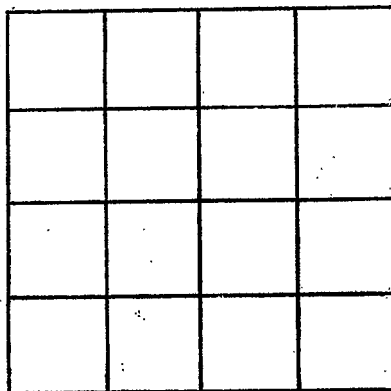

SECTION _____

Please indicate well location X.

ADDITIONAL INFORMATION

If more than one screen, show locations of each on sketch.