

MISSISSIPPI DEPARTMENT OF NATURAL RESOURCES

Bureau of Land and Water Resources

Southport Mall

P.O. Box 10631

Jackson, Mississippi 39209

WATER WELL DRILLERS LOG

CODED

WARREN
R27
8/80
File #166

date well completed: Aug 19 80 firm name: Guinn Water Well Serv county well located: Warren

LANDOWNER:	description of formations encountered	from	to
<u>Billy Chantin</u>			
(mailing address)			
WELL LOCATION:			
sec. <u>47</u> T. <u>14</u> N. R. <u>3</u> E			
miles _____ of _____			
(distance) (direction) (nearest town)			
WELL PURPOSE:			
(home, irrigation, municipal, industrial)			
WELL COMPLETION DATA:			
(1) diameter (inches) <u>6 1/2</u>			
(2) total depth (feet) <u>1741</u>			
(3) static water level (feet) <u>100</u> below top of ground.			
(4) casing <u>4" PVC</u> (material), <u>150</u> (depth)			
_____ (size) If telescope see back.			
(5) screen <u>20</u> (length), <u>150</u> (depth to top)			
<u>4"</u> (size), <u>PVC</u> (material)			
(6) pump <u>1/2</u> (HP), <u>10</u> (yield gpm)			
<u>ELEC</u> (type power)			
(7) electric log <u>yes</u> (yes or no)			
<u>MGS</u> (organization running log)			
(8) how well bottom plugged <u>BPV</u>			

CODED

DEPT. OF NATURAL RESOURCES  
BUREAU OF LAND & WATER RESOURCES


SEP 30 1980

RECEIVED

DRILLERS REMARKS:

If well telescopes please sketch and show depths.

GROUND LEVEL

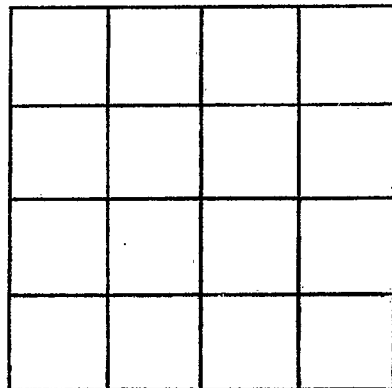

SECTION \_\_\_\_\_

Please indicate well location X.

ADDITIONAL INFORMATION

If more than one screen,  
show locations of each on sketch.