

WARREN
R28
3-23-81
Elog #167

MISSISSIPPI
BOARD OF WATER COMMISSIONERS
416 North State Street
Jackson, Mississippi 39201

CODED

WATER WELL DRILLERS LOG

3-23-1981 date well completed
Gunn well Ser Warren firm name
county well located

LANDOWNER:

John P. [Signature]

description of formations encountered

from to

Sand 0 70

(mailing address)

WELL LOCATION:

sec. 20 T 14 N R 3 E

(distance) miles (direction) of (nearest town)

CODED


WELL PURPOSE:

(home, irrigation, municipal, industrial)

WELL COMPLETION DATA:

- (1) diameter (inches) 4 1/2
- (2) total depth (feet) 70
- (3) static water level (feet) unk below top of ground.
- (4) casing PVC 50 (material), (depth)
- 4 1/2 (size) if telescope see back.
- (5) screen 20 50 (length), (depth to top)
- 1 1/2 PVC (size), (material)
- (6) pump unk (HP), (yield gpm)
- (type power)
- (7) electric log yes (yes or no)
- MAS (organization running log)
- (8) how well bottom plugged B&V

265 on log

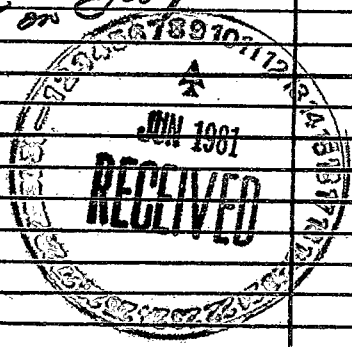

DRILLERS REMARKS:


If well telescopes please sketch and show depths.

GROUND LEVEL

SECTION _____

Please indicate well location X.

ADDITIONAL INFORMATION

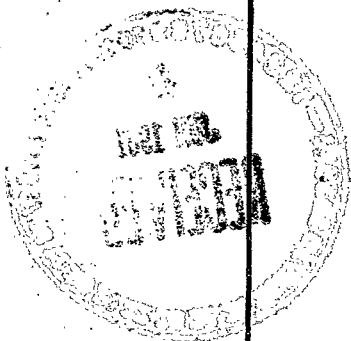

If more than one screen, show locations of each on sketch.