

MISSISSIPPI DEPARTMENT OF NATURAL RESOURCES

Bureau of Land and Water Resources

Southport Mall

P.O. Box 10631

Jackson, Mississippi 39209

CODED

WATER WELL DRILLERS LOG

WARREN
R 29
4-10-81

4-10-1981 date well completed Rayborn Drilling & Const. Co., Warren firm name Warren county well located

90 Wally sack 1500 #A 5 @ R22157

LANDOWNER:	description of formations encountered	from	to
0 9 H Corp			
Nicksalus, MS (mailing address)	chalk	5	142
WELL LOCATION: SW NE sec. 17 T 14 N R 3 E S W	fine sand	142	157
3 miles NE of Yalocena (distance) (direction) (nearest town)	chalk	157	220
WELL PURPOSE: (home, irrigation, municipal, industrial)	Rock	220	280
WELL COMPLETION DATA:	chalk	280	428
(1) diameter (inches) 4"	sand	428	440
(2) total depth (feet) 440			
(3) static water level (feet) 165 below top of ground.			
(4) casing Blk, 440' (material) (depth)			
4" if telescope see back. (size)			
(5) screen (length) (depth to top)			
(size) (material)			
(6) pump 60 GPM (HP) (yield gpm)			
(type power)			
(7) electric log no (yes or no)			
(organization running log)			
(8) how well bottom plugged wood plug			

Stalled
420-440

DEPT. OF NATURAL RESOURCES
BUREAU OF LAND & WATER RESOURCES


APR 16 1981

RECEIVED

DRILLERS REMARKS:

If well telescopes please sketch and show depths.

GROUND LEVEL

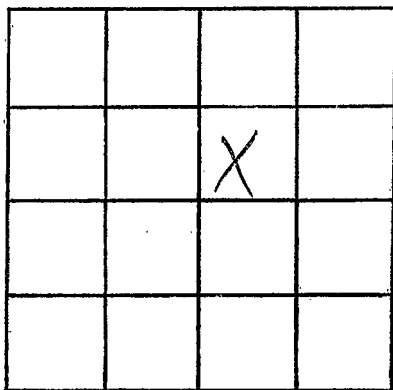

SECTION 17

Please indicate well location X.

ADDITIONAL INFORMATION

If more than one screen, show locations of each on sketch.