

MISSISSIPPI
 BOARD OF WATER COMMISSIONERS
 416 North State Street
 Jackson, Mississippi 39201

CODED

WATER WELL DRILLERS LOG

Warren
R 30
5-31-69

5/31 1969 BIG BLACK DRILLING CO. WARREN
 date well completed firm name county well located


LANDOWNER:	description of formations encountered	from	to
<u>RAYMOND LYNN</u>	<u>TOP SOIL</u>	<u>0</u>	<u>20</u>
<u>LE TOURNEAU</u> (mailing address)	<u>BROWN CHALK</u>	<u>20</u>	<u>40</u>
WELL LOCATION: sec. <u>9</u> T <u>14</u> N R <u>3</u> E <u>15</u> miles <u>SOUTH-SOUTH WEST</u> of <u>VICKSBURG</u> (distance) (direction) (nearest town)	<u>WHITE CHALK</u>	<u>40</u>	<u>50</u>
WELL PURPOSE: <u>HOME</u> (home, irrigation, municipal, industrial)	<u>SAND</u>	<u>50</u>	<u>71</u>
WELL COMPLETION DATA: (1) diameter (inches) <u>2"</u> (2) total depth (feet) <u>71"</u> (3) static water level (feet) <u>8'</u> below top of ground. (4) casing <u>2" GALV.</u> <u>61'</u> (material) (depth) (size) if telescope see back. (5) screen <u>10"</u> (length) (depth to top) <u>2"</u> (size) <u>STAINLESS STEEL</u> (material) (6) pump (HP) (yield gpm) (type power) (7) electric log <u>NO</u> (yes or no) (organization running log) (8) how well bottom plugged <u>BACK WASH VALVE</u>			
DRILLERS REMARKS:			

JUN 24 1969

MISS. BD. OF
 WATER COMMISSIONERS

If well telescopes please sketch and show depths.

GROUND LEVEL

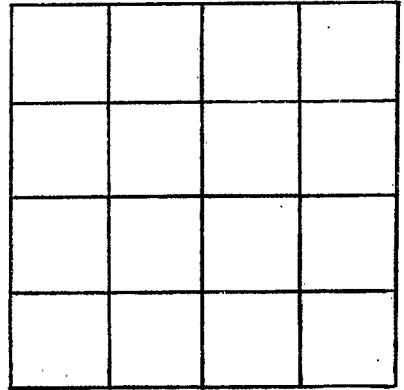

SECTION _____

Please indicate well location X.

ADDITIONAL INFORMATION

If more than one screen, show locations of each on sketch.