

R 2500
7-6-60

WATER WELL DRILLERS LOG

Date: 7-6, 1960, Driller: Setuch County: Warren
(Name)

(1) Owner of Land: J. B. Scott
(Name)
Vicksburg miss.
(Address) 143

(2) Location: 1/4, 1/4, Sec. 7 ~~T1E9~~
8 miles South, of Vicksburg
(distance) (direction) (Nearest Town)

(3) Topography: Hilly
(Hilly) (Flat) (Level)


(4) Purpose of Well: Domestic
(Domestic Irrigation
Municipal, Industrial, Other)

Description & Color of Materials Sand, Clay, Red Clay, Shell, etc.	Thick- ness Feet	Depth Feet
<u>0-93 clay</u>		
<u>93-97 sanded</u>		
<u>97-145 clay</u>		
<u>145-202 clay, lime stone</u>		
<u>202-258 clay - gravel</u>		
<u>258-270 gravel</u>		

Information upon completion of well:

- (1) Diameter 2 inches.
- (2) Total Depth 270 feet.
- (3) Water Level 104 feet below top of ground.
- (4) Cased to 258, Size 2'
- (5) Screen: Size 2", Length 12'
- (6) Were any formations sealed against pollution?
no yes, no no.

If YES depth of formation _____
Why _____
Drillers Remarks: _____

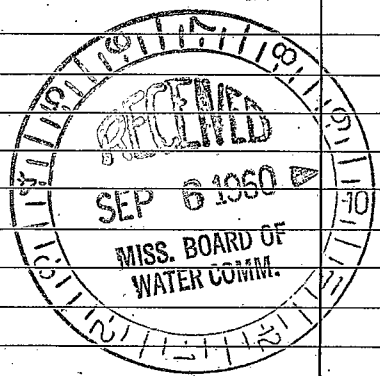

(Use Back Side)

Well No.

1870

1871

1872

1886