

Warren

MISSISSIPPI BOARD OF WATER COMMISSIONERS

R 2000

11-66

WATER WELL DRILLERS LOG

Date: NOV 15, 1966, Driller: E B FOAR County Warren

(Name)

(1) Owner of Land: W.C. Clark
(Name)

Rt 2 - Box 146 Vicksburg Miss
(Address)

(2) Location: SW 1/4, _____ 1/4, Sec. 27 N4 R3E

4 miles E of Hokema
(distance) (direction) (Nearest Town)

(3) Topography: Hills
(Hilly) (Flat) (Level)

(4) Purpose of Well: Domestic
(Domestic Irrigation
Municipal, Industrial, Other)

Description & Color of Materials
Sand, Clay, Red Clay, Shell, etc.

Thick-
ness
Feet

Depth
Feet

<u>Brown Sandy</u>	<u>33</u>	<u>33</u>
<u>Clay</u>		
<u>Red Clay</u>	<u>1</u>	<u>34</u>
<u>Red Clay & Gravel</u>	<u>26</u>	<u>60</u>
<u>Sand & Gravel</u>	<u>21</u>	<u>81</u>

Information upon completion of well:

(1) Diameter 4 inches.

(2) Total Depth 81 feet.

(3) Water Level 69 feet below top of ground.

(4) Cased to 76, Size 2"

(5) Screen: Size 2", Length 5"

(6) Were any formations sealed against pollution?


_____ yes, _____ no.

If YES depth of formation _____

Why _____

Drillers Remarks:

B.K. Powder
Added

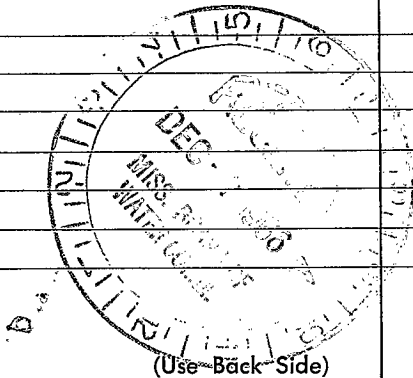

Well No.

