

Warren  
R 2003  
7-67

MISSISSIPPI  
BOARD OF WATER COMMISSIONERS  
416 North State Street  
Jackson, Mississippi 39201

WATER WELL DRILLERS LOG

July 20 1967 EB FORE Warren  
date well completed firm name county well located

LANDOWNER: K.V. Bell  
Rt 2 - Box 160  
Vicksburg Miss  
(mailing address)


WELL LOCATION:  
sec 32 T 14 N R 3 E  
15 miles South of Vicksburg  
(distance) (direction) (nearest town)

description of formations encountered	from	to
<u>Brown Sdy Cl</u>	<u>0</u>	<u>63</u>
<u>White clay &amp; sd streaks</u>	<u>63</u>	<u>78</u>
<u>White sand</u>	<u>78</u>	<u>105</u>

WELL PURPOSE: Home  
(home, irrigation, municipal, industrial)


- WELL COMPLETION DATA:
- (1) diameter (inches) 4 1/2"
- (2) total depth (feet) 105
- (3) static water level (feet) 62 below top of ground.
- (4) casing Galv, 100',  
(material) (depth)  
         if telescope see back.  
(size)
- (5) screen 5, 100'  
(length) (depth to top)  
.010, SS  
(size) (material)
- (6) pump 1 4  
(HP) (yield gpm)  
Elec  
(type power)
- (7) electric log No  
(yes or no)  
None  
(organization running log)
- (8) Backwash valve -  
how well bottom plugged

DRILLERS REMARKS:

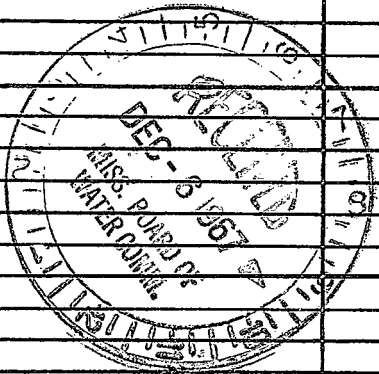

If well telescopes please sketch and show depths.

GROUND LEVEL

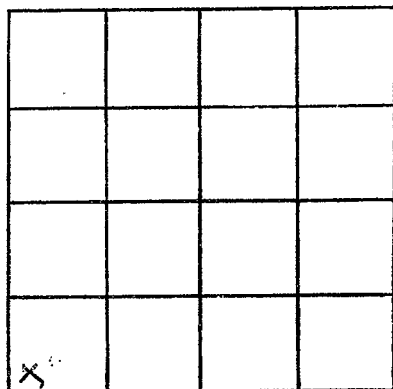

SECTION 32

Please indicate well location X.

ADDITIONAL INFORMATION

If more than one screen,  
show locations of each on sketch.