

Warren
R 2004
12-67

MISSISSIPPI
BOARD OF WATER COMMISSIONERS
416 North State Street
Jackson, Mississippi 39201

WATER WELL DRILLERS LOG

Dec 1 1967 EB Fore Warren
date well completed firm name county well located

LANDOWNER: J.O. HEARN Sr.
Hwy 61 S.
Vicksburg Miss.
(mailing address)

description of formations encountered	from	to
Brown Sdy cl	0	40
Brown & Grey cl	40	65
Blue Clay	65	80
Sand & Gravel	80	96

WELL LOCATION:
SW NE sec 4 T 14 N R 2 E
10 miles S of Vicksburg
(distance) (direction) (nearest town)

WELL PURPOSE: Home
(home, irrigation, municipal, industrial)

WELL COMPLETION DATA:

(1) diameter (inches) 4 1/4

(2) total depth (feet) 96

(3) static water level (feet) 61' below top of ground.

(4) casing Galv. 91' (material) (depth)

No (size) if telescope see back.

(5) screen 5' 91' (length) (depth to top)

2" SS (size) (material)


(6) pump 1 HP 10 (yield gpm)

Elec (type power)

(7) electric log No (yes or no)

None (organization running log)


(8) how well bottom plugged

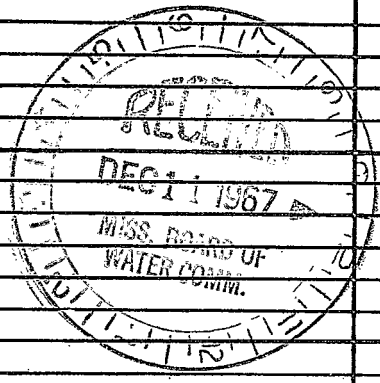

DRILLERS REMARKS:

If well telescopes please sketch and show depths.

GROUND LEVEL

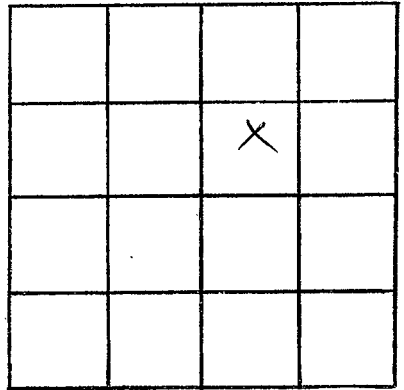

SECTION 14

Please indicate well location X.

ADDITIONAL INFORMATION

Lined area for additional information.

If more than one screen, show locations of each on sketch.