

WARREN
R 2005
7-14-77

MISSISSIPPI
BOARD OF WATER COMMISSIONERS
416 North State Street
155 Jackson, Mississippi 39201

WATER WELL DRILLERS LOG

July 14 1977 Grenn Water Well Cont. Warren
date well completed firm name county well located

LANDOWNER: Huey Dunn
P.O. Box 3A
Vicksburg, Miss.
(mailing address)

description of formations encountered	from	to
Loess	1	35
white clay	35	70
sand	70	85
white clay	85	100
blue clay	100	180
sand	180	193

JE
NE

WELL LOCATION:
sec. 8 T. 14N R. 3 E
-S -W-
10 miles N of Port Gibson
(distance) (direction) (nearest town)

WELL PURPOSE: home
(home, irrigation, municipal, industrial)

- WELL COMPLETION DATA:
- (1) diameter (inches) 6
 - (2) total depth (feet) 193
 - (3) static water level (feet) 90 below top of ground.
 - (4) casing PVC, 181' (material) (depth)
4" (size) if telescope see back.
 - (5) screen 12' 181' (length) (depth to top)
.010 PVC (size) (material)
 - (6) pump 3/4 HP sub 10 (HP) (yield gpm)
electricity (type power)
 - (7) electric log no (yes or no)
(organization running log)
 - (8) how well bottom plugged back wash valve

DRILLERS REMARKS:


RECEIVED

AUG 24 1977

MISS. BD. OF WATER COMMISSIONERS

If well telescopes please sketch and show depths.

GROUND LEVEL

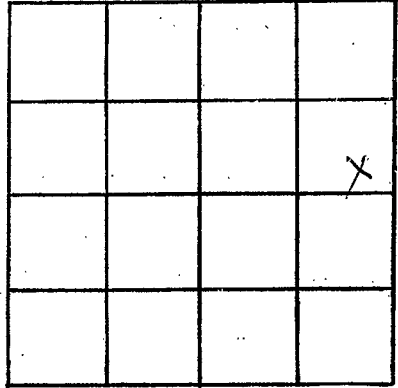

SECTION 8

Please indicate well location X.

ADDITIONAL INFORMATION

Lined area for additional information.

If more than one screen, show locations of each on sketch.