

AS 10
4-17-62

WATER WELL DRILLERS LOG

CODED

Date: 4-17, 19 62 Driller: *[Signature]* County: Warren
(Name)

- (1) Owner of Land: *E. M. Dealey*
(Name)
Warrenton
(Address)
- (2) Location: 1/4 1/4, Sec. 5 1/4 R 9
1.8 miles south of *[Town]*
(distance) (direction) (Nearest Town)
- (3) Topography: *High*
(Hilly) (Flat) (Level)
- (4) Purpose of Well: *None*
(Domestic Irrigation
Municipal, Industrial, Other)

Description & Color of Materials Sand, Clay, Red Clay, Shell, etc.	Thick- ness Feet	Depth Feet
<i>0-49 Red clay 49-69 white sand</i>		


Information upon completion of well:

- (1) Diameter: 2 inches.
- (2) Total Depth: 69 feet.
- (3) Water Level: 47 feet below top of ground.
- (4) Cased to: 69, Size: 2
- (5) Screen: Size: 2, Length: 5
- (6) Were any formations sealed against pollution?
 yes, no.

CODED

If YES depth of formation:
Why:

Drillers Remarks:
very good well

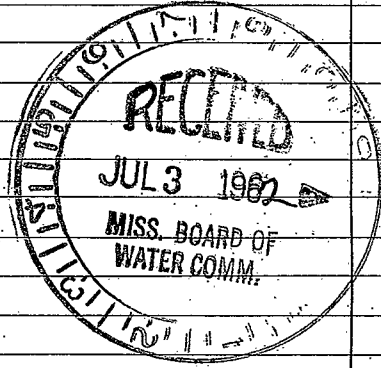

(Use Back Side)

Well No.

