

18 1966
WARREN

Driller: *Alan [Signature]*

CODED

(Name)

(1) Owner of Land: *James Cowart*
(Name)
Wepshung Miss
(Address)

(2) Location: *1/4*, *1/4*, Sec. *9 T. 14 R.*
14 miles *South* of *Wepshung*
(distance) (direction) (Nearest Town)

(3) Topography: *Hilly*
(Hilly) (Flat) (Level)

(4) Purpose of Well: *Home*
(Domestic Irrigation
Municipal, Industrial, Other)

Description & Color of Materials
Sand, Clay, Red Clay, Shell, etc.

Thick-
ness
Feet

Depth
Feet

0-18 clay
18-52 shale
52-70 sand

Information upon completion of well:

(1) Diameter *2 1/2* inches.

(2) Total Depth *70'* feet.

(3) Water Level *40'* feet below top of ground.

(4) Cased to *65'*, Size *2"*


(5) Screen: Size *2"*, Length *5'*

(6) Were any formations sealed against pollution?
yes, *no*.

If YES depth of formation _____

Why _____

Drillers Remarks: _____

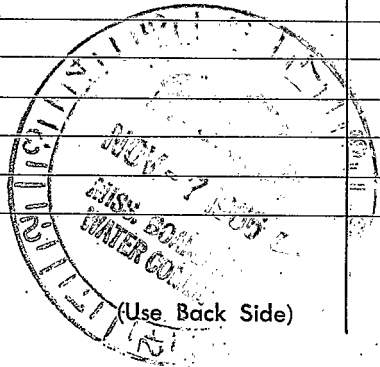

Well No.

Retain this copy for your office files.

