

Warren  
 513  
 E Loc #127  
 8-2-74

MISSISSIPPI  
 BOARD OF WATER COMMISSIONERS  
 416 North State Street  
 Jackson, Mississippi 39201

CODED ✓  
 CODED

WATER WELL DRILLERS LOG

19 Jack Guinn  
 date well completed firm name

Warren  
 county well located

| LANDOWNER:  | description of formations encountered | from      | to         |
|---|---------------------------------------|-----------|------------|
| <u>ROSS, O.R.</u>   | <u>TOP SOIL</u>                       | <u>0</u>  | <u>1</u>   |
| (mailing address)   | <u>CLAY Yellow</u>                    | <u>1</u>  | <u>45</u>  |
| WELL LOCATION:  | <u>ROCK</u>                           | <u>45</u> | <u>65</u>  |
| sec. <u>19</u> T. <u>14</u> N. R. <u>4</u> E                        | <u>CLAY</u>                           | <u>65</u> | <u>70</u>  |
| <u>10</u> miles <u>S</u> of <u>VIKT</u>                             | <u>SAND</u>                           | <u>70</u> | <u>100</u> |
| (distance) (direction) (nearest town)                               |                                       |           |            |
| WELL PURPOSE:<br>(home, irrigation, municipal, industrial)          |                                       |           |            |
| WELL COMPLETION DATA:   |                                       |           |            |
| (1) diameter (inches) <u>4 1/2</u>                                  |                                       |           |            |
| (2) total depth (feet) <u>110</u>                                   |                                       |           |            |
| (3) static water level (feet) <u>93</u> <u>below</u> top of ground. |                                       |           |            |
| (4) casing <u>T&amp;L</u> <u>105</u><br>(material) (depth)          |                                       |           |            |
| <u>4 1/2</u> If telescope see back.<br>(size)                       |                                       |           |            |
| (5) screen <u>5'</u> <u>105</u><br>(length) (depth to top)          |                                       |           |            |
| <u>4"</u> <u>SS</u><br>(size) (material)                            |                                       |           |            |
| (6) pump <u>1</u> <u>8</u><br>(HP) (yield gpm)                      |                                       |           |            |
| <u>MPL</u><br>(type power)  |                                       |           |            |
| (7) electric log <u>yes</u><br>(yes or no)                          |                                       |           |            |
| <u>WIK</u><br>(organization running log)                            |                                       |           |            |
| (8) how well bottom plugged <u>BWC</u>                              |                                       |           |            |
| DRILLERS REMARKS: <u>Log RAY</u><br><u>never received</u>           |                                       |           |            |


CODED

DEC 19 1974

MISS. BD. OF WATER COMM.

If well telescopes please  
sketch and show depths.

GROUND LEVEL

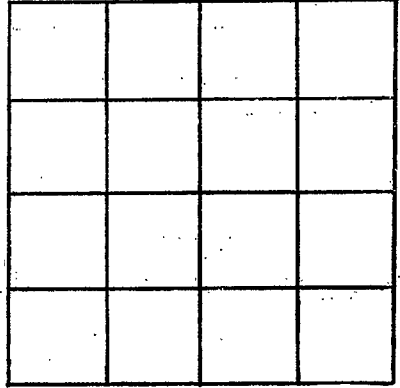

SECTION \_\_\_\_\_

Please indicate well location X.

ADDITIONAL INFORMATION

If more than one screen,  
show locations of each on sketch.