

Warren  
 S 2000  
 7-67

MISSISSIPPI  
 BOARD OF WATER COMMISSIONERS  
 416 North State Street  
 Jackson, Mississippi 39201

WATER WELL DRILLERS LOG

July 15 1967 EB FORE WARREN  
 date well completed firm name county well located

LANDOWNER: Mr. Sam Rice

description of formations encountered

from to

Fisher 3 way Rd.  
Vicksburg, Miss  
 (mailing address)

Brown Sdy Clay 0 24

Sd & Gravel 24 34

WELL LOCATION:

sec. 5 T. 14 N R. 4 E  
10 miles S of Vicksburg  
 (distance) (direction) (nearest town)

Red Sdy Cl 34 40

Sd & gravel 40 54

WELL PURPOSE: Home  
 (home, irrigation, municipal, industrial)

White Cl. 54 70

WELL COMPLETION DATA:

Rock 70 72

(1) diameter (inches) 4 1/2

Blue Cl 72 112

(2) total depth (feet) 131

Sand Gravel 112 131

(3) static water level (feet) 11 1/2 below top of ground.

(4) casing, Galv, 12 1/2,  
 (material) (depth)

NO if telescope see back.  
 (size)

(5) screen 5, 12 1/2  
 (length) (depth to top)

2", SS  
 (size) (material)

(6) pump 1, 4 1/2  
 (HP) (yield gpm)


Elec  
 (type power)

(7) electric log No  
 (yes or no)

None  
 (organization running log)


(8) Backwash  
 how well bottom plugged

DRILLERS REMARKS:

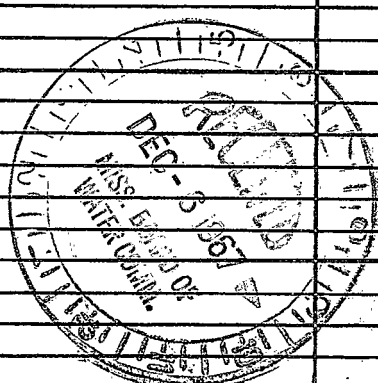

If well telescopes please sketch and show depths.

GROUND LEVEL

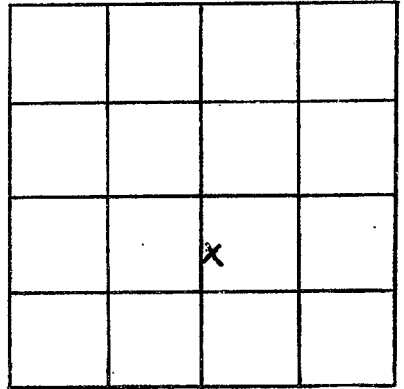

SECTION 5

Please indicate well location X.

ADDITIONAL INFORMATION

If more than one screen,  
show locations of each on sketch.