

Warren
S 2001
1009-99

MISSISSIPPI
BOARD OF WATER COMMISSIONERS
416 North State Street
Jackson, Mississippi 39201

WATER WELL DRILLERS LOG

Oct. 9 1979 R.M. "Bud" Cresswell Warren
date well completed firm name county well located

LANDOWNER:
Bobby Richardson
Vicksburg, Ms.
(mailing address)

description of formations encountered	from	to
	Clay	0
Sand	90	100
Clay	100	130
Sand	130	180

WELL LOCATION:
sec. 14 T 14 N R 4 E
10 miles South of Vicksburg
(distance) (direction) (nearest town)

WELL PURPOSE: home
(home, irrigation, municipal, industrial)

WELL COMPLETION DATA:
(1) diameter (inches) 2
(2) total depth (feet) 180
(3) static water level (feet) 50 below top of ground
(4) casing PVC 160 (material) (depth)
2 (size) If telescope see back.
(5) screen 20 160 (length) (depth to top)
2 PVC (size) (material)
(6) pump 1 10 (HP) (yield gpm)
0 (type power)
(7) electric log no (yes or no)
0 (organization running log)

(8) how well bottom plugged
Steel Plug


DRILLERS REMARKS:

DEPT. OF NATURAL RESOURCES
BUREAU OF LAND & WATER RESOURCES

NOV - 6 1979
RECEIVED

If well telescopes please
sketch and show depths.

GROUND LEVEL

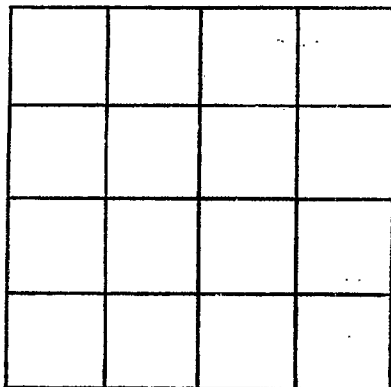

SECTION _____

Please indicate well location X.

ADDITIONAL INFORMATION

If more than one screen,
show locations of each on sketch.