

A 35

11-17-63

WATER WELL DRILLERS LOG

11/30/63  
C 1693

Date: Nov. 17, 1963, Driller: Layne-Central Company County Washington

(Name)

(1) Owner of Land: P. F. Watzek  
(Name)  
Greenville, Mississippi  
(Address)  
(2) Location: 1/4, 1/4, Sec. 14 T. 9N R. 9W  
5 miles northwest of Greenville  
(distance) (direction) (Nearest Town)  
(3) Topography: flat  
(Hilly) (Flat) (Level)  
(4) Purpose of Well: domestic  
(Domestic Irrigation  
Municipal, Industrial, Other)

Description & Color of Materials Sand, Clay, Red Clay, Shell, etc.	Thick- ness Feet	Depth Feet
Clay	26	26
Fine gray sand	21	47
Sand	8	55
Coarse sand	23	78
Coarse sand & pea gravel	25	103
Clay	59	162
Sand	13	175
Clay	78	253
Shale	65	318
Sandy shale	49	367
Rock	1	368
Sandy shale strks. sand	38	406
Sand	149	555

Information upon completion of well:


(1) Diameter 8x4 inches.  
(2) Total Depth 556 feet.  
(3) Water Level 58' feet below top of ground.  
(4) Cased to 327' - 11" Size 4"  
200' - 4" Size 8"  
20' lap  
(5) Screen: Size 4", Length 40' - 9"  
(6) Were any formations sealed against pollution?  
yes yes, no no.

If YES depth of formation Mechanical seal  
and Back Pressure Valve.

Why \_\_\_\_\_

Drillers Remarks: \_\_\_\_\_

E-log #48 to 553'

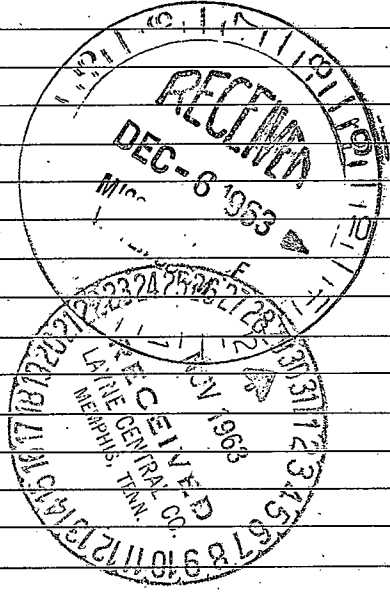

(Use Back Side)

Well No.

