

WASH. MISSISSIPPI BOARD OF WATER COMMISSIONERS

A36

11-20-65

WATER WELL DRILLERS LOG

Date: Nov. 20, 1965, Driller: DELTA DRILLING Co. County WASHINGTON

(Name)

FORKLAND PLANTATION
 (1) Owner of Land: A. H. REED
GREENVILLE, MISS.
 LOCATION -
WINTERVILLE, MISS.
 (Address)
 (2) Location: NE 1/4, SE 1/4, Sec. 3 T19N R8W
 _____ miles _____ of _____
 (distance) (direction) (Nearest Town)
 (3) Topography: _____
 (Hilly) (Flat) (Level)
 (4) Purpose of Well: DOMESTIC
 (Domestic Irrigation
 Municipal, Industrial, Other)

Description & Color of Materials Sand, Clay, Red Clay, Shell, etc.	Thick- ness Feet	Depth Feet
Sand	78	78
gravel	33	111
gumbo w/ Rocks-	93	204
Shale	60	264
gumbo w/ROCKS-	15	279
Shale	16	295
gumbo	22	317
Shale	16	333
gumbo w/ROCKS	40	373
Shale	19	392
Sand	121	513

Information upon completion of well:


(1) Diameter 4 inches.
 (2) Total Depth 513 feet.
 (3) Water Level _____ feet below top of ground.
 (4) Cased to _____, Size 4" 93'
2 1/2" 400'
 (5) Screen: Size 2", Length 20'
 (6) Were any formations sealed against pollution?
 _____ yes, _____ no.

If YES depth of formation _____

Why _____

Drillers Remarks:

E-log #54 to 503 ft

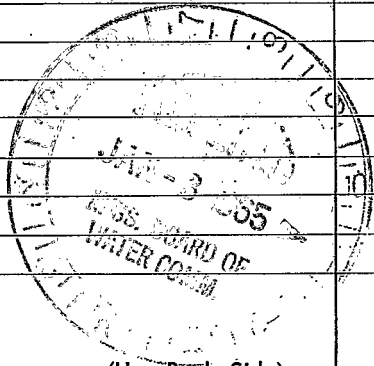

(Use Back Side)

Well No.

