

A38

4-10-63

WATER WELL DRILLERS LOG

C1505 4/15/63
Washington

Date: April 10, 1963, Driller: Layne-Central Company County, Bolivar

(Name)

(1) Owner of Land: Delta & Pine Land Co.
(Name)
Scott, Mississippi
(Address)
-Carson Plantation 19N
(2) Location: 1/4, 1/4, Sec. 27 T R9W,
7 miles south, of Scott
(distance) (direction) (Nearest Town)
(3) Topography: flat
(Hilly) (Flat) (Level)
(4) Purpose of Well: irrigation
(Domestic Irrigation
Municipal, Industrial, Other)

Description & Color of Materials Sand, Clay, Red Clay, Shell, etc.	Thick- ness Feet	Depth Feet
Clay	4	4
Fine sand	6	10
Blue clay balls	5	15
Clay balls fine sand	10	25
Fine blue sand	23	48
Medium sand	7	55
Coarse sand	17	72
Coarse sand pea gravel	20	92
Coarse sand boulders	20	112
Clay		112


Information upon completion of well:

- (1) Diameter 16 inches.
(2) Total Depth 112 feet.
(3) Water Level 9' - 4" feet below top of ground.
(4) Cased to 62', Size 16"
(5) Screen: Size 16", Length 50'
(6) Were any formations sealed against pollution?
no yes, no no.

If YES depth of formation _____

Why _____

Drillers Remarks: _____

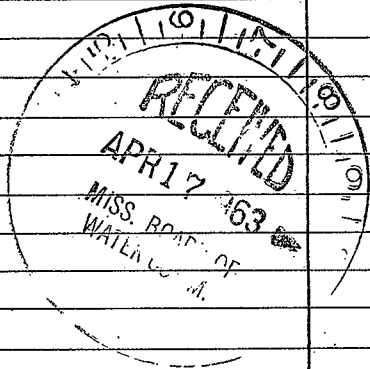

(Use Back Side)

Well No.

1000000000

1000000000

