

Washington
 A 41
 10-67

MISSISSIPPI
 BOARD OF WATER COMMISSIONERS
 416 North State Street
 Jackson, Mississippi 39201

WATER WELL DRILLERS LOG

10 Dec 67 19 Delta Pump & Water Well Wash.
 date well completed firm name county well located

LANDOWNER: Miss. Valley Gas Co

Greenville, Miss.

(mailing address)

WELL LOCATION:

sec. 32 T. 19 N. R. 8 E. S. 5
2 miles N of Greenville
 (distance) (direction) (nearest town)


WELL PURPOSE: home.
 (home, irrigation, municipal, industrial)

WELL COMPLETION DATA:

- (1) diameter (inches) 4x2
- (2) total depth (feet) 461
- (3) static water level (feet) 71 ^{below}/_{above} top of ground.
- (4) casing Steel, 461,
 (material) (depth)
4x2 if telescope see back.
 (size)
- (5) screen 20, 461
 (length) (depth to top)
2", Stainless Steel
 (size) (material)
- (6) pump 3 (HP) (yield gpm)
Elect
 (type power)
- (7) electric log _____
 (yes or no)

 (organization running log)
- (8) how well bottom plugged Steel capped plugs

description of formations encountered	from	to
<u>Mixed</u>	<u>0</u>	<u>15</u>
<u>Sand</u>	<u>15</u>	<u>30</u>
<u>Sand & Gravel</u>	<u>30</u>	<u>90</u>
<u>blue clay</u>	<u>90</u>	<u>210</u>
<u>blue shale</u>	<u>210</u>	<u>300</u>
<u>Coarse Sand</u>	<u>300</u>	<u>500</u>

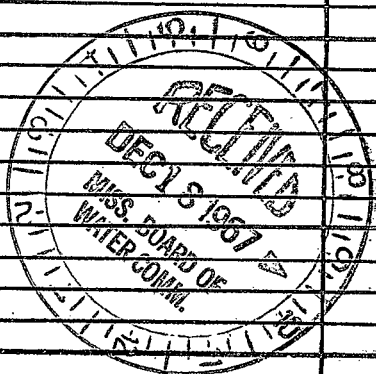

DRILLERS REMARKS:

If well telescopes please sketch and show depths.

GROUND LEVEL

4''

147'


2''

44j' @

2'' screen

20'

If more than one screen, show locations of each on sketch.

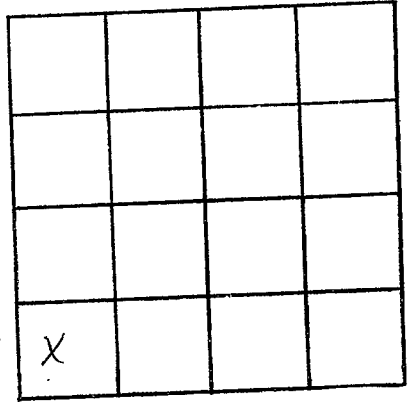

lot 5

SECTION 32

Please indicate well location X.

ADDITIONAL INFORMATION

Multiple horizontal lines for recording additional information.