

WASH.

MISSISSIPPI BOARD OF WATER COMMISSIONERS

A42

12-11-61

WATER WELL DRILLERS LOG

CODED

A

Date: 12/11, 1961, Driller: Bulky Drilling Co County: Washington

(1) Owner of Land	Description & Color of Materials Sand, Clay, Red Clay, Shell, etc.	Thick- ness Feet	Depth Feet
<u>Greenville Garden Club</u> (Name) <u>Greenville, Miss.</u> (Address)	<u>Clay</u>	<u>70</u>	<u>70</u>
	<u>Sand</u>	<u>22</u>	<u>92</u>
	<u>Sand + gravel</u>	<u>8</u>	<u>100</u>
	<u>Mud</u>	<u>380</u>	<u>480</u>
	<u>Sand</u>	<u>43</u>	<u>523</u>

(2) Location: NE 1/4, NE 1/4, Sec. 19 N 19 R 8 W
8 miles North of Greenville
(distance) (direction) (Nearest Town)

(3) Topography: Flat
(Hilly) (Flat) (Level)


(4) Purpose of Well: Park
(Domestic Irrigation
Municipal, Industrial, Other)

Information upon completion of well:

- (1) Diameter 3 X 2 inches.
- (2) Total Depth 508 feet.
- (3) Water Level 46 feet below top of ground.
- (4) Cased to all way Size 3 X 2
- (5) Screen: Size 2, Length 10ft
- (6) Were any formations sealed against pollution?
_____ yes, X no.

If YES depth of formation _____
Why _____
Drillers Remarks: _____

CODED

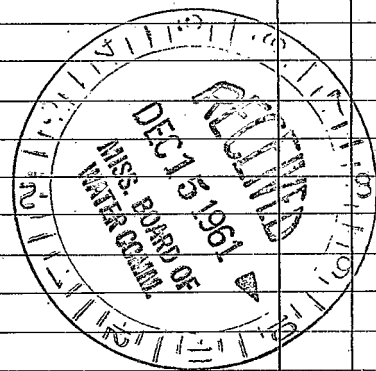

(Use Back Side)

Well No.

100

100

