


BA 44

1-28-65

WATER WELL DRILLERS LOG

CODED

Date: 1/28, 1965, Driller: Bailey Drilling Co., County: Washington

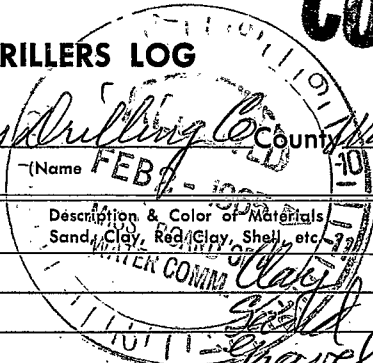

(1) Owner of Land: J. C. Parrish
 (Name)
 Avon, Miss.
 (Address)

(2) Location: NW 1/4, SW 1/4, Sec. 27 T9 R8
 2 miles N of Greenville
 (distance) (direction) (Nearest Town)

(3) Topography: Flat
 (Hilly) (Flat) (Level)

(4) Purpose of Well: Domestic
 (Domestic Irrigation
 Municipal, Industrial, Other)

Description & Color of Materials Sand, Clay, Red Clay, Shell, etc.	Thick- ness Feet	Depth Feet
Clay		30
Sand		90
Gravel		140
Mud		170
Sand		471

Information upon completion of well:

(1) Diameter: 4 X 2 inches.

(2) Total Depth: 471 feet.

(3) Water Level: 54 feet below top of ground.

(4) Cased to: all way, Size 4 X 2

(5) Screen: Size 2", Length 10ft.

(6) Were any formations sealed against pollution?
 yes, X no.

CODED

If YES depth of formation _____

Why _____

Drillers Remarks: _____

(Use Back Side)

Well No.

100
101
102
200