

Washington  
 O A 45  
 9-67

MISSISSIPPI  
 BOARD OF WATER COMMISSIONERS  
 416 North State Street  
 Jackson, Mississippi 39201

WATER WELL DRILLERS LOG

9/22 1967 Bailey Drilling Co Washington  
 date well completed firm name county well located

LANDOWNER: W E Hammett  
 Greenville  
 Miss.  
 (mailing address)


description of formations encountered	from	to
Clay	0	40
Sand	40	95
Mud	95	131
Sand & Mud	131	500

WELL LOCATION:  
 sec. 14 T. 19 N R. 8 E  
 10 miles N of Greenville  
 (distance) (direction) (nearest town)

WELL PURPOSE: Home  
 (home, irrigation, municipal, industrial)

- WELL COMPLETION DATA:
- (1) diameter (inches) 4 X 2
  - (2) total depth (feet) 500
  - (3) static water level (feet) 48 below top of ground.
  - (4) casing Steel (material), (depth) 4 X 2 if telescope see back.
  - (5) screen 10' (length), 490 (depth to top), 2" (size), Stainless Steel (material)
  - (6) pump 3/4 (HP), 15 (yield gpm), E6c (type power)
  - (7) electric log No (yes or no)
  - (organization running log)
  - (8) how well bottom plugged Back pressure valve

DRILLERS REMARKS:

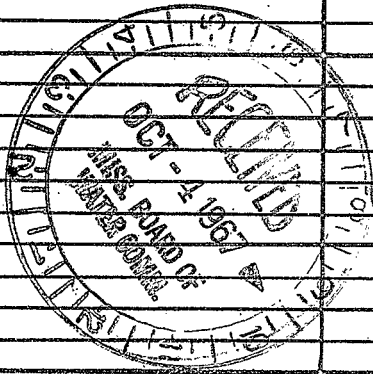


If well telescopes please sketch and show depths.

GROUND LEVEL

126' d'

76' 2"

10' strainer

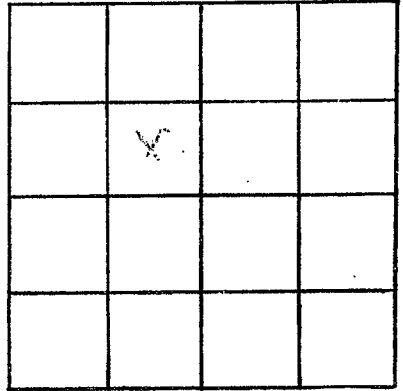

SECTION 14

Please indicate well location X.

ADDITIONAL INFORMATION

If more than one screen, show locations of each on sketch.