

WASH.
A46
9-1-61

WATER WELL DRILLERS LOG

CODED

Date: 9/1, 1961, Driller: Bailey Drlg. Co. County: Washington
(Name)

(1) Owner of Land: Willie Taylor
(Name)
Metcalf, Miss.
(Address)

(2) Location: NE 1/4, NE 1/4, Sec. 34 T19R8,
at Metcalfe
miles (distance) (direction) (Nearest Town)

(3) Topography: Flat
(Hilly) (Flat) (Level)

(4) Purpose of Well: domestic
(Domestic Irrigation
Municipal, Industrial, Other)

Description & Color of Materials Sand, Clay, Red Clay, Shell, etc.	Thick- ness Feet	Depth Feet
<u>Clay</u>	<u>25</u>	<u>25</u>
<u>Sand</u>	<u>62</u>	<u>87</u>
<u>Gravel + Sand</u>	<u>13</u>	<u>100</u>
<u>Mud</u>	<u>95</u>	<u>195</u>
<u>Sand</u>	<u>65</u>	<u>260</u>
<u>Coal</u>	<u>2</u>	<u>262</u>
<u>Sand</u>	<u>220</u>	<u>482</u>

Information upon completion of well:

(1) Diameter 2 inches.

(2) Total Depth 477 feet.

(3) Water Level 30 feet below top of ground.

(4) Cased to all way Size 2

(5) Screen: Size 2, Length 8


(6) Were any formations sealed against pollution?
 _____ yes, X no.

If YES depth of formation _____

Why _____

Drillers Remarks: _____

CODED

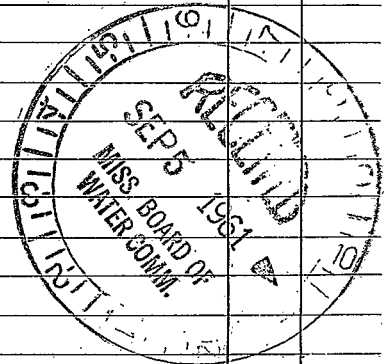

(Use Back Side)

Well No.

1942