

Washington  
 A47  
 3-67

MISSISSIPPI  
 BOARD OF WATER COMMISSIONERS  
 416 North State Street  
 Jackson, Mississippi 39201

WATER WELL DRILLERS LOG

3-18 1967 date well completed  
 67 Ave. County Farmers Comm firm name  
 Washington county well located

LANDOWNER: Della + Pine  
 Land Co  
 Scott Miss  
 (mailing address)


description of formations encountered	from	to
Top Soil		14
Clay	19 1/2	40
Sand + Gravel	71 1/2	111 1/2
Clay on		

WELL LOCATION:  
 SE 1/4 Sec 25 T19 N R 9 E  
 3 miles South of Scott  
 (distance) (direction) (nearest town)

WELL PURPOSE: irrigation  
 (home, irrigation, municipal, industrial)

- WELL COMPLETION DATA:
- (1) diameter (inches) 6
  - (2) total depth (feet) 110'
  - (3) static water level (feet) 15' 6" <sup>below</sup> above top of ground.
  - (4) casing 6" Pipe, 62'  
 (material) (depth)  
 6" if telescope see back.  
 (size)
  - (5) screen 48' of 6" 62'  
 (length) (depth to top)  
 6" Down  
 (size) (material)
  - (6) pump 30 1000  
 (HP) (yield gpm)  
 Tractor  
 (type power)
  - (7) electric log No  
 (yes or no)  
 (organization running log)
  - (8) how well bottom plugged - welded

DRILLERS REMARKS:

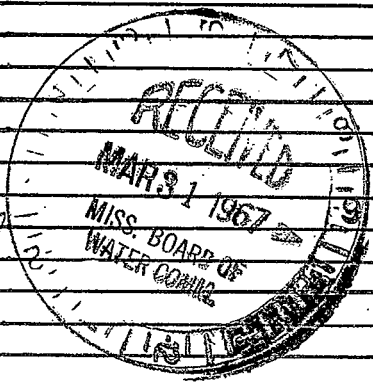

If well telescopes please sketch and show depths.

GROUND LEVEL


SECTION \_\_\_\_\_

Please indicate well location X.

ADDITIONAL INFORMATION

If more than one screen,  
show locations of each on sketch.