

A 49

11-13-62

WATER WELL DRILLERS LOG **CODED**

Date: 11/13, 1962, Driller: Bailey Drly. Co. County Washington
(Name)

(1) Owner of Land:	Description & Color of Materials Sand, Clay, Red Clay, Shell, etc.	Thick- ness Feet	Depth Feet
<u>Jack McQueen</u> <small>(Name)</small>	<u>Clay</u>		<u>40</u>
<u>Priscilla, Miss.</u> <small>(Address)</small>	<u>Sand</u>		<u>90</u>
(2) Location: <u>NE 1/4, SW 1/4, Sec. 2</u> T <u>19</u> ^N R <u>8</u> ^W	<u>Gravel</u>		<u>102</u>
<u>11</u> miles <u>north</u> , of <u>Greenville</u> <small>(distance) (direction) (Nearest Town)</small>	<u>Mud</u>		<u>385</u>
(3) Topography: <u>Flat</u> <small>(Hilly) (Flat) (Level)</small>	<u>Sand + Mud</u>		<u>415</u>
(4) Purpose of Well: <u>Domestic</u> <small>(Domestic Irrigation Municipal, Industrial, Other)</small>	<u>Sand</u>		<u>442</u>
	<u>Mud</u>		<u>453</u>
	<u>Sand</u>		<u>465</u>
	<u>Mud</u>		<u>486</u>
	<u>Sand</u>		<u>521</u>

Information upon completion of well:


- (1) Diameter 3 X 2 inches.
- (2) Total Depth 521 feet.
- (3) Water Level 38 feet below top of ground.
- (4) Cased to all way Size 3 X 2
- (5) Screen: Size 2, Length 10 ft.
- (6) Were any formations sealed against pollution?
 yes, no.

If YES depth of formation _____

Why _____

Drillers Remarks: _____

CODED

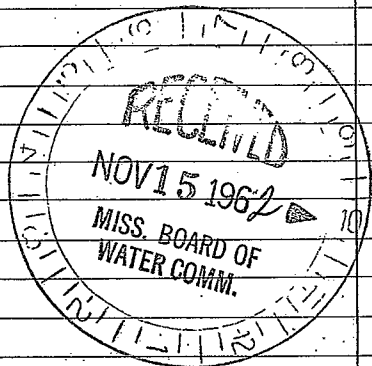

(Use Back Side)

Well No.

1952

1953

1954

1978