

Washington

A50

MISSISSIPPI BOARD OF WATER COMMISSIONERS

9-66

WATER WELL DRILLERS LOG

Date: 9/29, 1966, Driller: Parley Drilling Co, County: Washington
PO Box 5335, Greenville, Miss.


(1) Owner of Land: A H Garner
(Name)
Greenville, Miss.
(Address)
(2) Location: SW 1/4, SW 1/4, Sec. 30 T12R8W
3 miles N, of Greenville
(distance) (direction) (Nearest Town)
(3) Topography: Flat
(Hilly) (Flat) (Level)
(4) Purpose of Well: Domestic
(Domestic Irrigation
Municipal, Industrial, Other)

Description & Color of Materials Sand, Clay, Red Clay, Shell, etc.	Thick- ness Feet	Depth Feet
Clay	40	40
Sand	30	70
Gravel	10	80
Mud	260	340
Fine sand	45	385
Mud	25	420
Sand	66	486

Information upon completion of well:

(1) Diameter 4 X 2 inches.
(2) Total Depth 486 feet.
(3) Water Level 79 feet below top of ground.
(4) Cased to all way size 4 X 2
(5) Screen: Size 2", Length 10 ft.
(6) Were any formations sealed against pollution?
yes, X no.

If YES depth of formation _____
Why _____
Drillers Remarks: _____

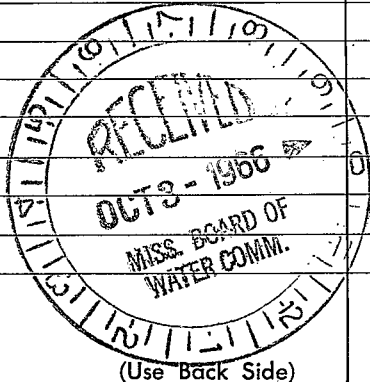

Well No.

