

DASH.

MISSISSIPPI BOARD OF WATER COMMISSIONERS

MS 51

3-11-66

WATER WELL DRILLERS LOG

CODED

Date: 3/11, 1966, Driller: Bailey Drlg Co, County: Washington

| | Description & Color of Materials Sand, Clay, Red Clay, Shell, etc. | Thick- ness Feet | Depth Feet |
|--|---|------------------------|--------------------------|
| (1) Owner of Land: <u>Winston Walker</u> (Name) <u>Metcalf, Miss.</u> (Address) | Clay | | 28 |
| (2) Location: <u>NW 1/4, NW 1/4, Sec 26 19^N 8^W</u> <u>1</u> miles <u>N</u> of <u>Metcalf</u> (distance) (direction) (Nearest Town) | Sand Gravel Mud Sand | | 100 130 475 575 |
| (3) Topography: <u>Flat</u> (Hilly) (Flat) (Level) | | | |
| (4) Purpose of Well: <u>Domestic</u> (Domestic Irrigation Municipal, Industrial, Other) | | | |

CODED

Information upon completion of well:

(1) Diameter 4 X 3 inches.

(2) Total Depth 575 feet.

(3) Water Level 52 feet below top of ground.

(4) Cased all way Size 4 X 3.


(5) Screen: Size 3", Length 30 ft.

(6) Were any formations sealed against pollution?
 yes, no.

If YES depth of formation _____

Why _____

Drillers Remarks: _____

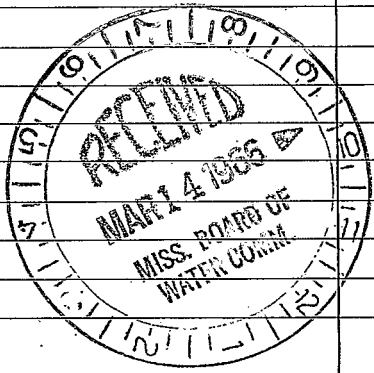

(Use Back Side)

Well No.

