

A 52

12-7-63

WATER WELL DRILLERS LOG

CODED

Date: 12/7, 1963, Driller: Bailey Drilling Co County: Washington
 (Name)


(1) Owner of Land: Tony Formigoni
 (Name)
Greenville, Miss.
 Metcalf Address: Rd 34
 (2) Location: SW 1/4, NW 1/4, Sec. 36 T. 19 N. R. 8 W.
4 miles North of Greenville
 (distance) (direction) (Nearest Town)
 (3) Topography: Flat
 (Hilly) (Flat) (Level)
 (4) Purpose of Well: domestic
 (Domestic Irrigation, Municipal, Industrial, Other)

Description & Color of Materials Sand, Clay, Red Clay, Shell, etc.	Thick- ness Feet	Depth Feet
<u>Clay</u>		<u>12</u>
<u>Sand</u>		<u>65</u>
<u>Gravel</u>		<u>89</u>
<u>Mud</u>		<u>115</u>
<u>Sand & Mud</u>		<u>379</u>
<u>Sand</u>		<u>410</u>
<u>Sand & Mud</u>		<u>420</u>
<u>Sand</u>		<u>432</u>
<u>Mud</u>		<u>461</u>
<u>Sand</u>		<u>493</u>

Information upon completion of well:

(1) Diameter: 3 X 2 inches.
 (2) Total Depth: 493 feet.
 (3) Water Level: 52 feet below top of ground.
 (4) Cased to: all way Size 3 X 2.
 (5) Screen: Size 2; Length 10.
 (6) Were any formations sealed against pollution?
 _____ yes, X no.

CODED

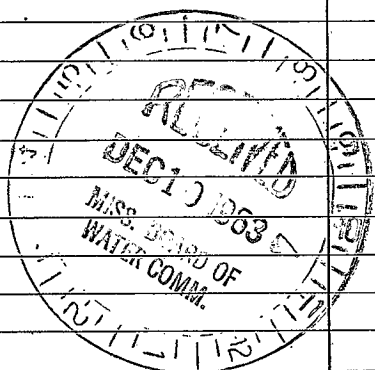

If YES depth of formation _____
 Why _____
 Drillers Remarks: _____

(Use Back Side)

Well No.

