

WASH. MISSISSIPPI BOARD OF WATER COMMISSIONERS
A-53
6-22-65

WATER WELL DRILLERS LOG

1/12/65
C 2001

Date: June 22, 1965, Driller: Layne-Central Company County Washington

(Name)

(1) Owner of Land: Shamrock Plantation (Name)

Metcalfe, Mississippi (Address)

(2) Location: 1/4, 1/4, Sec. 25 T19N R8W
miles, of Metcalfe (distance, direction, Nearest Town)

(3) Topography: flat (Hilly, Flat, Level)

(4) Purpose of Well: domestic (Domestic Irrigation, Municipal, Industrial, Other)

Description & Color of Materials Sand, Clay, Red Clay, Shell, etc.	Thick-ness Feet	Depth Feet
Sandy clay	10	10
Clay	9	19
Fine sand	21	40
Coarse sand	18	58
Fine sand & clay	15	73
Coarse sand & pea gravel	25	98
Blue clay	27	125
White hard clay	13	138
Blue clay	45	183
Clay with sandy clay strks.	47	230
Clay	88	318
Clay with fine sand strks.	23	341
Rock	1	342
Clay with fine sand strks.	27	369
Fine sand & clay	39	408
Clay & small fine sand strks.	34	442
Sand	68	510
Clay & sand	4	514

Information upon completion of well:


- (1) Diameter 4 inches.
- (2) Total Depth 514 feet.
- (3) Water Level 50 feet below top of ground.
- (4) Cased to 478' - 3", Size 4".
- (5) Screen: Size 4", Length 30' - 9".
5' of 4" Blank
- (6) Were any formations sealed against pollution?

yes yes, no.

If YES depth of formation Packer at the top of screen. Flugged bottom.

Why

Drillers Remarks:

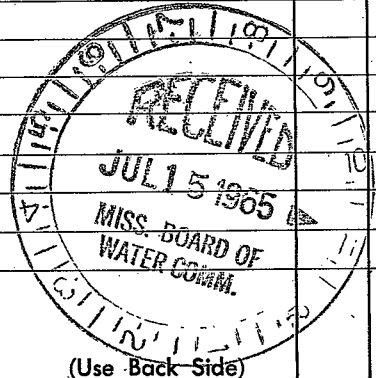

Well No.

