

WASH.

A 56

6-24-64

WATER WELL DRILLERS LOG

**CODED**

Date: 6/24, 1964, Driller: Bailey Mfg. Co County: Washington  
(Name)

(1) Owner of Land:	Description & Color of Materials Sand, Clay, Red Clay, Shell, etc.	Thick- ness Feet	Depth Feet
<u>Peoples Gin Co</u> (Name) <u>Winterville, Miss.</u> (Address)	<u>Clay</u>		<u>30</u>
(2) Location: <u>SE 1/4, SE 1/4, Sec. 7</u> <u>T 9 R 8</u> <u>at Winterville</u> miles _____, of _____ (distance) (direction) (Nearest Town)	<u>Sand</u>		<u>75</u>
(3) Topography: <u>Flat</u> (Hilly) (Flat) (Level)	<u>Gravel</u>		<u>100</u>
(4) Purpose of Well: <u>Gin</u> (Domestic Irrigation Municipal, Industrial, Other)	<u>Mud</u>		<u>460</u>
	<u>Fine Sand</u>		<u>572</u>
	<u>Mud</u>		<u>500</u>
	<u>Mud</u>		<u>565</u>
	<u>Sand</u>		<u>597</u>

Information upon completion of well:


- (1) Diameter 4x3 inches.
- (2) Total Depth 597 feet.
- (3) Water Level 50 feet below top of ground.
- (4) Cased to all way Size 4x3
- (5) Screen: Size 3, Length 20 ft
- (6) Were any formations sealed against pollution?  
\_\_\_\_\_ yes, X no.

**CODED**

If YES depth of formation \_\_\_\_\_

Why \_\_\_\_\_

Drillers Remarks: \_\_\_\_\_

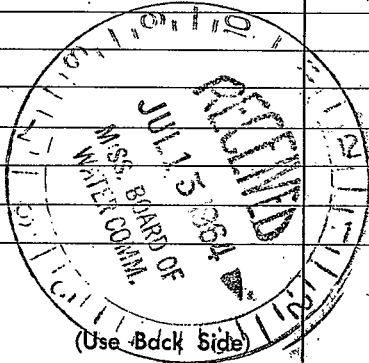

Well No.

200

1