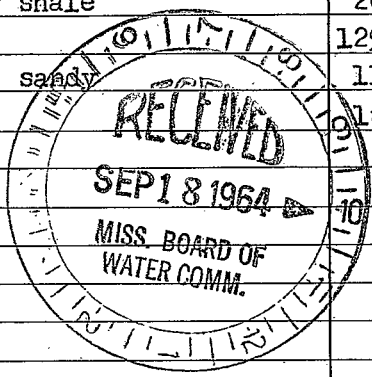


A 57
8-26-64

WATER WELL DRILLERS LOG

9/16/64
1864
J

Date: August 26, 1964, Driller: Layne-Central Company County Washington
(Name)

	Description & Color of Materials Sand, Clay, Red Clay, Shell, etc.	Thick- ness Feet	Depth Feet
(1) Owner of Land: <u>D. K. Morrow</u> (Name) <u>Greenville, Mississippi</u> (Address)	Clay	30	30
(2) Location: <u>1/4, 1/4, Sec. 12 T19N R8W</u> <u>4</u> miles <u>south</u> of <u>Stringtown</u> (distance) (direction) (Nearest Town)	Sand	76	106
(3) Topography: <u>flat</u> (Hilly) (Flat) (Level)	Gravel	3	109
(4) Purpose of Well: <u>domestic</u> (Domestic Irrigation Municipal, Industrial, Other)	Clay pink	11	120
Information upon completion of well:	Lime stone	4	124
(1) Diameter <u>4</u> inches.	Sandy shale	56	180
(2) Total Depth <u>478</u> feet.	Clay	118	298
(3) Water Level <u>40</u> feet below top of ground.	Rock	2	300
(4) Cased to <u>405' -10"</u> , Size <u>4"</u>	Sandy shale	20	320
(5) Screen: Size <u>4"</u> , Length <u>40' -2"</u>	Sand	129	449
(6) Were any formations sealed against pollution? <u>yes</u> yes, <u>no</u> no.	Shale sandy	11	460
If YES depth of formation <u>Packer 21' above</u>	Clay	18	478
Why <u>screen, and</u> <u>metallic bottom.</u>			
Drillers Remarks:			

(Use Back Side)

Well No.

