

CODED

MISSISSIPPI
BOARD OF WATER COMMISSIONERS
416 North State Street
Jackson, Mississippi 39201

WATER WELL DRILLERS LOG

Washington
A 58
4-68

4/4 1968 Bailey Drilling Co Washington
date well completed firm name county well located


LANDOWNER: Mounds Plantation
Winterville
Miss.
(mailing address)

description of formations encountered	from	to
Clay	0	30
Sand	30	80
Gravel	80	110
Mud	110	FTS
Sand	FTS	124

WELL LOCATION:
sec. 8 T. 19 N R. 8 E
at Winterville
(distance) (direction) (nearest town)

WELL PURPOSE: Farm
(home, irrigation, municipal, industrial)

- WELL COMPLETION DATA:
- (1) diameter (inches) 4x2 1/2
 - (2) total depth (feet) 527
 - (3) static water level (feet) 53 below top of ground.
 - (4) casing Steel (material), (depth) 4x2 1/2 if telescope see back.
 - (5) screen 20 (length), 504 (depth to top), 2 1/2 (size), Stainless Steel (material)
 - (6) pump 2 (HP), 30 (yield gpm), Elec (type power)
 - (7) electric log No (yes or no)
 - (8) how well bottom plugged back pressure valve

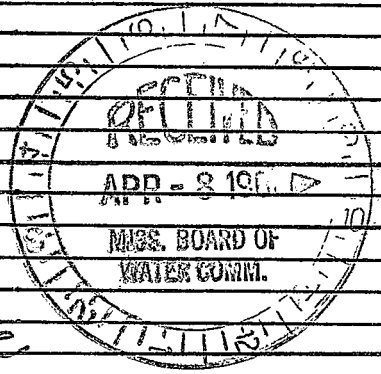

DRILLERS REMARKS:

If well telescopes please sketch and show depths.

GROUND LEVEL

0.0 ft

2.57 ft

20 ft

X			

SECTION 5

Please indicate well location X.

ADDITIONAL INFORMATION

If more than one screen, show locations of each on sketch.