

Washington  
 A 59  
 3/68

MISSISSIPPI  
 BOARD OF WATER COMMISSIONERS  
 416 North State Street  
 Jackson, Mississippi 39201

WATER WELL DRILLERS LOG

7 mar 68 19 L & W Pump & Water Well Ser. Wash  
 date well completed firm name county well located

LANDOWNER: V.C. Hamme H Jr

Greenville, Miss.

(mailing address)

WELL LOCATION:

sec 3 T. 19 (N) R. 8 (E)  
12 miles north of Greenville  
 (distance) (direction) (nearest town)

WELL PURPOSE:

(home, irrigation, municipal, industrial)

WELL COMPLETION DATA:

- (1) diameter (inches) 4x3x2 1/2  
4x2 1/2
- (2) total depth (feet) 450
- (3) static water level (feet) 34 <sup>below</sup>/<sub>above</sub> top of ground.
- (4) casing galv. 430  
(material) (depth)  
4x2 1/2 if telescope see back.  
(size)
- (5) screen 20' 450  
(length) (depth to top)  
2 1/2" S Steel  
(size) (material)
- (6) pump 2' sub 3600/hr.  
(HP) 5 (yield gpm)  
Elect 60  
(type power)
- (7) electric log \_\_\_\_\_  
(yes or no)  
(organization running log)
- (8) how well bottom plugged Steel  
plug

description of formations encountered

from

to

Clay

0 30

Sand

30 60

Sand & pea gravel

60 109

Blue Clay

109 115

Sand

115 125

Blue Clay

125 180

Sand

180 200

Clay

200 220

Sand

220 230

Clay

230 240

Sand

240 255

Clay

255 265

Rock

265 268

Sand

268 400

Clay

400 410

Good Sand

410 450

DRILLERS REMARKS:

If well telescopes please sketch and show depths.

GROUND LEVEL

4''

126'

~~3 1/2~~

3''

42'


2 1/2''

262'

20''

2 1/2'' screen

If more than one screen, show locations of each on sketch.

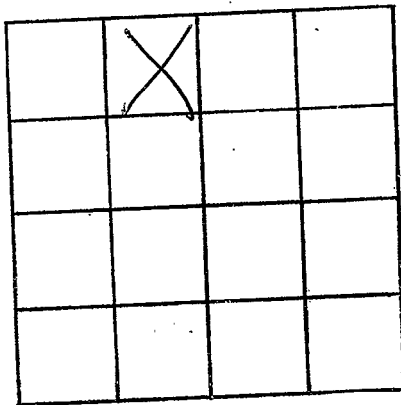

SECTION 3

Please indicate well location X.

ADDITIONAL INFORMATION

