

Washington
 A Col
 7-68

MISSISSIPPI
 BOARD OF WATER COMMISSIONERS
 416 North State Street
 Jackson, Mississippi 39201

CODED

WATER WELL DRILLERS LOG

1 July 1968 date well completed
 LHW Pamphlet water well serv firm name
 Wash. county well located

LANDOWNER: Miss. State Parks
 Winter Ground State Park
 Hwy 1 N.
 Greenville, Miss.
 (mailing address)

WELL LOCATION:
 sec. 18 T 19 S R 8 E
 5 miles N of Greenville
 (distance) (direction) (nearest town)


WELL PURPOSE: none
 (home, irrigation, municipal, industrial)

WELL COMPLETION DATA:

- (1) diameter (inches) 2x4
- (2) total depth (feet) 300
- (3) static water level (feet) 46 (below top of ground)
- (4) casing galv. (material) (depth)
- ✓ if telescope see back.
 (size)
- (5) screen 20' (length) 300 (depth to top)
 2" (size) plastic (material)
- (6) pump 2 (HP) 300 45 (yield gpm)
 Elect (type power)
- (7) electric log (yes or no)
 (organization running log)
- (8) how well bottom plugged Backwash.

DRILLERS REMARKS:

description of formations encountered	from	to
Mixed sand	0	15
clay	15	30
sand	30	60
sand	60	80
pea gravel	80	105
clay	105	135
sand	135	170
clay	170	185
sand	185	250
clay	250	263
sand (good)	263	300

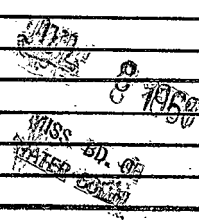

If well telescopes please sketch and show depths.


GROUND LEVEL

105
4"

175
2"

20'
2" screen.

If more than one screen,
show locations of each on sketch.

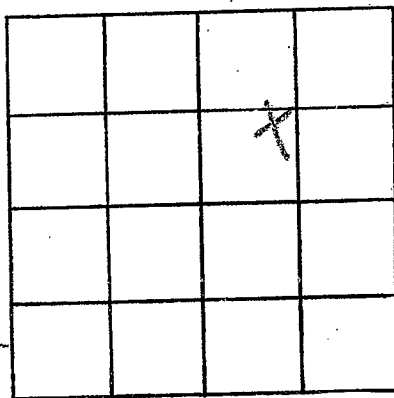

SECTION 18

Please indicate well location X.

ADDITIONAL INFORMATION

Lined area for additional information.