

A62  
7-10-62

WATER WELL DRILLERS LOG

Washington  
CODED  
LeFlore

Date: 7-10, 1962, Driller: BUTANE GAS CO. OF WOOD County: LE FLORE

(Name)

- (1) Owner of Land: G.A. HARRISON  
(Name)  
HOUSTON, TEXAS  
(Address)
- (2) Location: NW 1/4, NW 1/4, Sec. 8 T 8 R 19N 7W  
(distance) 6 miles NW (direction), of STONEVILLE (Nearest Town)
- (3) Topography: FLAT  
(Hilly) (Flat) (Level)
- (4) Purpose of Well: IRRIGATION  
(Domestic Irrigation, Municipal, Industrial, Other)

Description & Color of Materials Sand, Clay, Red Clay, Shell, etc.	Thick- ness Feet	Depth Feet
<u>BLACK HOT</u>	<u>5</u>	<u>5</u>
<u>RED CLAY</u>	<u>18</u>	<u>23</u>
<u>SILTY SAND</u>	<u>11</u>	<u>34</u>
<u>COARSE SAND</u>	<u>12</u>	<u>46</u>
<u>SAND PER ROCK</u>	<u>14</u>	<u>60</u>
<u>PER GRAVEL &amp; GRAVEL</u>	<u>56</u>	<u>116</u>


Information upon completion of well:

- (1) Diameter 16 inches.
- (2) Total Depth 116 feet.
- (3) Water Level: 16' 5" feet below top of ground.
- (4) Cased to 68', Size 16"
- (5) Screen: Size 12", Length 48'
- (6) Were any formations sealed against pollution?  
\_\_\_\_\_ yes, X no.

If YES depth of formation \_\_\_\_\_  
Why \_\_\_\_\_

Drillers Remarks: \_\_\_\_\_

Insuff. info  
to locate

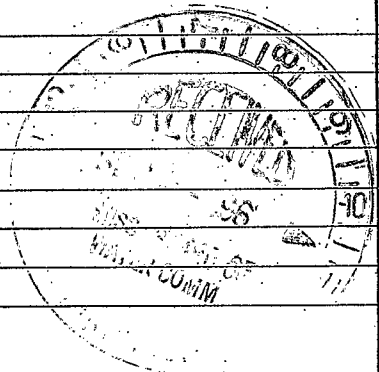

(Use Back Side)

Well No.

[The page contains extremely faint and illegible text, likely bleed-through from the reverse side of the document. The text is scattered across the page and does not form any recognizable words or sentences.]