

A-63
3-61

WATER WELL DRILLERS LOG

CODED

Washington

Date: MAR, 1961, Driller: BENTANE GAS Co of BOGALOUS County LEFEVRE

(Name)

(1) Owner of Land: G. A. HARRISON

(Name)

Houston Texas

(Address)

(2) Location: NW 1/4, NW 1/4, Sec. 15 T 19 N R 3 W

9 miles NW of LEBAND

(distance)

(direction)

(Nearest Town)

(3) Topography: FLAT

(Hilly)

(Flat)

(Level)

(4) Purpose of Well: IRRIGATION

(Domestic Irrigation
Municipal, Industrial, Other)

Description & Color of Materials Sand, Clay, Red Clay, Shell, etc.	Thick- ness Feet	Depth Feet
CLAY	17	17
SILT	11	28
COARSE SAND	14	42
COARSE SAND PEB ROCK	32	74
PEB ROCK & GRAVEL	32	106
CLAY	2	108

CODED

Information upon completion of well:

(1) Diameter 16 inches.

(2) Total Depth 108 feet.

(3) Water Level 16 feet below top of ground.

(4) Cased to 60', Size 16"

(5) Screen: Size 12", Length 48'

(6) Were any formations sealed against pollution?


yes, X no.

If YES depth of formation

Why

Drillers Remarks:

Inst. in
to locate

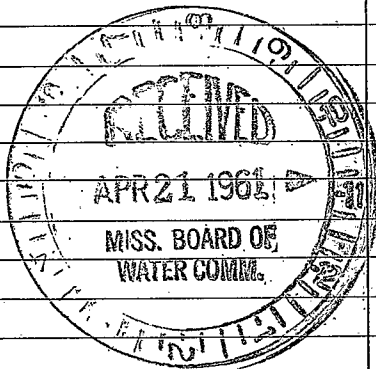

(Use Back Side)

Well No.

