

A-64
1-3-64

WATER WELL DRILLERS LOG

CODED

Date: 1/3, 1964, Driller: Bailey & Co Washington
(Name) (County)

(1) Owner of Land: L.O. See
(Name)
Greenville, Miss.
(Address)
Lake Ferguson 32 19N 8W
(2) Location: 1/4, 1/4, Sec. T R
10 miles North, of Greenville
(distance) (direction) (Nearest Town)
(3) Topography: Flat
(Hilly) (Flat) (Level)
(4) Purpose of Well: Domestic
(Domestic Irrigation
Municipal, Industrial, Other)

Description & Color of Materials Sand, Clay, Red Clay, Shell, etc.	Thick- ness Feet	Depth- Feet
<u>Clay</u>		<u>15</u>
<u>Sand</u>		<u>72</u>
<u>Gravel</u>		<u>105</u>
<u>Mud</u>		<u>150</u>
<u>Rock</u>		<u>157</u>
<u>Mud</u>	<u>309</u>	<u>349?</u>
<u>Sand</u>		<u>442</u>


Information upon completion of well:

(1) Diameter 2 inches.
(2) Total Depth 442 feet.
(3) Water Level: 50 feet below top of ground.
(4) Cased to all way size 2.
(5) Screen: Size 2, Length 10 ft.
(6) Were any formations sealed against pollution?
_____ yes, X no.

CODED

If YES depth of formation _____
Why _____
Drillers Remarks: _____

Instr. info.
to locate

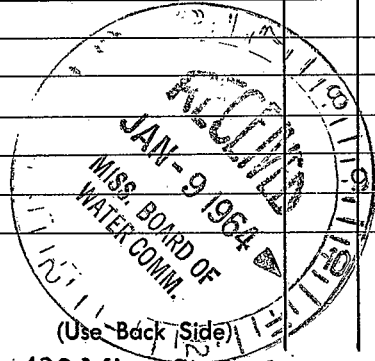

Well No.

