

WASH.

MISSISSIPPI BOARD OF WATER COMMISSIONERS

A 63

7-16-63

WATER WELL DRILLERS LOG

CODED

Date: 7/16, 1963, Driller: [Name], County: Washington


(1) Owner of Land: Harold Bell
 (Name)
 Greenville, Miss.
 (Address)

(2) Location: 1/4, 1/4, Sec. 19 19N8W
 5 miles North of Greenville
 (distance) (direction) (Nearest Town)

(3) Topography: Flat
 (Hilly) (Flat) (Level)

(4) Purpose of Well: Domestic
 (Domestic Irrigation
 Municipal, Industrial, Other)

Description & Color of Materials Sand, Clay, Red Clay, Shell, etc.	Thick- ness Feet	Depth Feet
Clay		35
Sand		45
Gravel		105
Mud		369
Sand		405
Sand + Mud		450
Sand		482

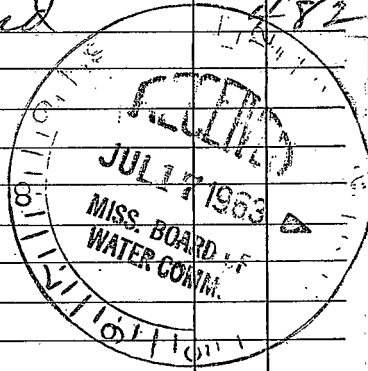

CODED

Information upon completion of well:

(1) Diameter 4 X 2 1/2 inches.

(2) Total Depth 482 feet.

(3) Water Level 50 feet below top of ground.

(4) Cased to all way, Size 4 X 2 1/2

(5) Screen: Size 2 1/2", Length 20ft.

(6) Were any formations sealed against pollution?
 yes, no.

If YES depth of formation _____

Why _____

Drillers Remarks: Insuff. info to locate

Well No.

(Use Back Side)

