

Washington
A 106
9-29-69

CODED

MISSISSIPPI
 BOARD OF WATER COMMISSIONERS
 416 North State Street
 Jackson, Mississippi 39201

CODED

WATER WELL DRILLERS LOG

9/29 1969 Boiley Drlg. Co. Washington
 date well completed firm name county well located

LANDOWNER: Mrs. Geo. Edwards
Greenville
Miss.
 (mailing address)

description of formations encountered	from	to
	<u>Clay</u>	<u>0</u>
<u>Sand</u>	<u>30</u>	<u>60</u>
<u>Gravel</u>	<u>60</u>	<u>75</u>
<u>Mud</u>	<u>75</u>	<u>370</u>
<u>Sand</u>	<u>370</u>	<u>464</u>

WELL LOCATION:
 sec 32 T 19 N R 8 E
6 miles NE of Greenville
 (distance) (direction) (nearest town)

WELL PURPOSE: Home
 (home, irrigation, municipal, industrial)

- WELL COMPLETION DATA:
- (1) diameter (inches) 4 X 2
 - (2) total depth (feet) 464
 - (3) static water level (feet) 67 below above top of ground.
 - (4) casing Steel, 449,
 (material) (depth)
4 X 2 if telescope see back.
 (size)
 - (5) screen 15', 449
 (length) (depth to top)
2", Stainless Steel
 (size) (material)
 - (6) pump 1 20
 (HP) (yield gpm)
Elec
 (type power)
 - (7) electric log No
 (yes or no)
- (organization running log)

(8) how well bottom plugged
Back pressure valve

DRILLERS REMARKS:

OCT 1 - 1969

MISS. BO. OF WATER COMM.


If well telescopes please sketch and show depths.

GROUND LEVEL

147' 0"

502' 0"

15' Screen

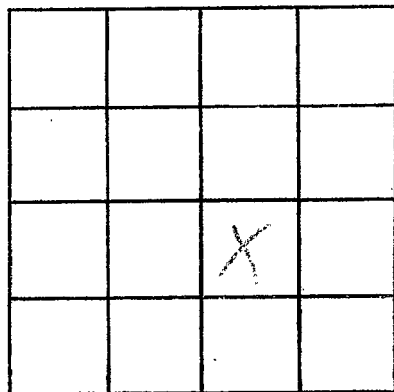

SECTION 22

Please indicate well location X.

ADDITIONAL INFORMATION

If more than one screen, show locations of each on sketch.