

WASH. MISSISSIPPI BOARD OF WATER COMMISSIONERS

A ~~72~~ 72
3-27-57

WATER WELL DRILLERS LOG

CODED

366

Date: March 27, 1957, Driller: Layne-Central Company County, Washington

(Name)

Weathers

- (1) Owner of Land: Metcalf and
(Name)
Greenville, Mississippi
(Address)
- (2) Location: 1/4, 1/4, Sec. 18 19 N 8 W, T R
4 miles north of Greenville
(distance) (direction) (Nearest Town)
- (3) Topography: flat
(Hilly) (Flat) (Level)
- (4) Purpose of Well: irrigation
(Domestic Irrigation
Municipal, Industrial, Other)

Description & Color of Materials Sand, Clay, Red Clay, Shell, etc.	Thick- ness Feet	Depth Feet
Clay	23	23
Fine sand & clay	9	32
Sand	10	42
Sand & clay balls	6	48
Blue clay	4	52
Blue clay	7	59
Coarse sand & pea rock	3	62
Coarse sand & pea rock	10	72
Sand & gravel	10	82
Sand & pea rock	10	92
Sand & gravel	9	101
Clay	1	102

Information upon completion of well:

- (1) Diameter 18x12 inches.
- (2) Total Depth 101 feet.
- (3) Water Level 18' - 7" feet below top of ground.
- (4) Cased to 58', Size 18"
4' swage
- (5) Screen: Size 12", Length 40'
- (6) Were any formations sealed against pollution?
no yes, no no.

CODED

*Insert info
to locate*


If YES depth of formation _____

Why _____

Drillers Remarks: _____

2360 GPM

engine drive

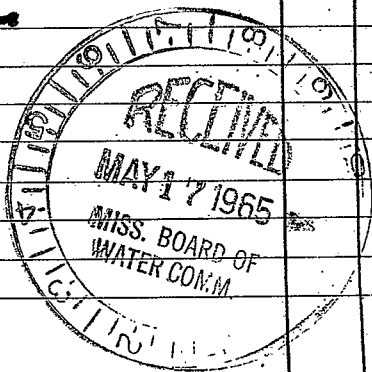

(Use Back Side)

Well No.

