

WASH.
A 73
6-10-71

MISSISSIPPI
BOARD OF WATER COMMISSIONERS
416 North State Street
Jackson, Mississippi 39201

6-10-71
CODED

WATER WELL DRILLERS LOG

10 June 1971 date well completed
Lambert Drilling Co. firm name
Wash county well located

LANDOWNER: J.D. Walker
Hwy 1 South
Greenville, Miss.
(mailing address)

description of formations encountered	from	to
mixed	0	15
sand	15	60
sand & gravel	60	88
clay blue	88	185
Rock	185	186
clay	186	285
sand, tight	285	357
sand & clay str.	357	384
sand.	384	405
sand good	405	416

WELL LOCATION:
sec 33 T 19 N R 8 E
6 W
miles of (distance) (direction) (nearest town)

WELL PURPOSE: Home
(home, irrigation, municipal, industrial)

WELL COMPLETION DATA:
(1) diameter (inches) 4X2
(2) total depth (feet) 450
(3) static water level (feet) 46 below top of ground.
(4) casing ~~4X2~~ 430 (material) (depth).
4X2 if telescope see back. (size)
(5) screen 20' 450-430 (length) (depth to top)
2" 8.5' (size) (material)
(6) pump 1 20 (HP) (yield gpm)
Elet (type power)
(7) electric log no (yes or no)

(8) how well bottom plugged backwash
(organization running log)

DRILLERS REMARKS:
Housley left hand

CODED

JUN 18 1971

MISS. B.P. 50
WATER BOARD

If well telescopes please sketch and show depths.

GROUND LEVEL

130

4"

300


2"

20

2"

Screen

If more than one screen, show locations of each on sketch.

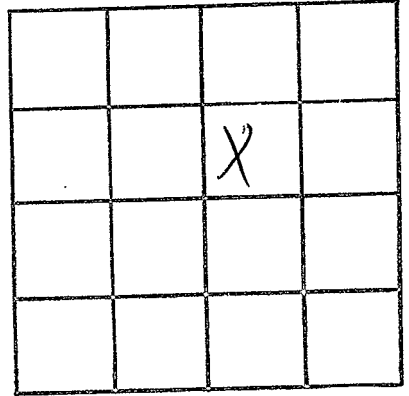

SECTION 33

Please indicate well location X.

ADDITIONAL INFORMATION

Lined area for additional information.