

MISSISSIPPI
BOARD OF WATER COMMISSIONERS
416 North State Street
Jackson, Mississippi 39201

CODED

WATER WELL DRILLERS LOG

WASHINGTON
A 74
10-23-71

6/23 1971 Schwitz Drilling Co. Washington
date well completed firm name county well located

LANDOWNER: <u>Martin Martin</u>	description of formations encountered	from	to
<u>Nenterville, Miss</u> (mailing address)	<u>clay</u>	<u>0</u>	<u>12</u>
	<u>sand</u>	<u>12</u>	<u>100</u>

WELL LOCATION:
sec. 18 T. 19 N. R. 9 E
1 miles W of Nenterville
(distance) (direction) (nearest town)

WELL PURPOSE: drinking
(home, irrigation, municipal, industrial)

- WELL COMPLETION DATA:
- (1) diameter (inches) 4 1/2
 - (2) total depth (feet) 90
 - (3) static water level (feet) 19 below top of ground.
 - (4) casing Plastic (material), (depth) _____
(size) If telescope see back.
 - (5) screen 10 (length), (depth to top) _____
4 1/2 (size), Plastic (material)
 - (6) pump _____ (HP), _____ (yield gpm)
(type power)
 - (7) electric log no (yes or no)
 - (organization running log)
 - (8) how well bottom plugged Plugged

CODED


JUL 9 1971

MISS. RD. OF
WATER COM.

DRILLERS REMARKS:

If well telescopes please sketch and show depths.

GROUND LEVEL

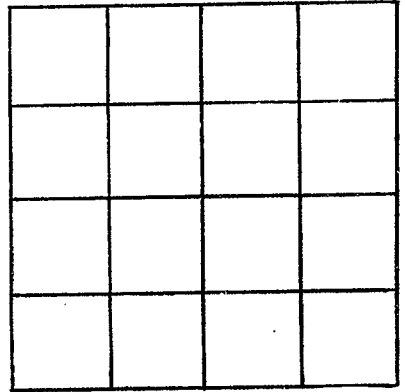

SECTION _____

Please indicate well location X.

ADDITIONAL INFORMATION

If more than one screen, show locations of each on sketch.